

WEST

EAST

SOUTH


Cased _____ in. _____ ft.
 Sand _____
 Gas _____
 Oil _____
 Total Depth _____



1st 24 hrs. Nat. -----
 1st 24 hrs. after shot -----
 Gas ----- cu. ft.
 Dry Hole -----
 Abandoned -----


1120 Ft. from S. Line

Ft. srom E. Line

200 Ft from W. Line

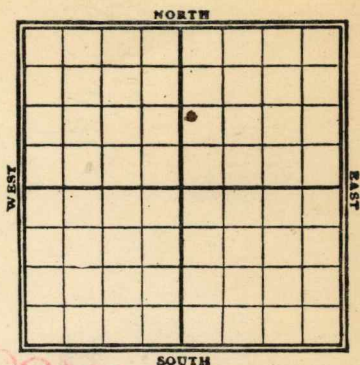

REPORT

Date _____

9-26	Rising up.
12-2-1	

1921

1/27	2508-29. shot 60 gts/100 bbl.
------	----------------------------------

Map No. K11 Sec. 18 Twp. 29 R. 6Well No. 2 Parmenter
Mid-Kansas Oil Company

Contractor _____

SECTION PLAT

_____ Ft. from N. Line
1120 Ft. from S. Line
 _____ Ft. from E. Line
200 Ft. from W. Line

		0	

FIRST REPORT

Location _____

Rig up ☒

Drilling and Remarks:

RECORD

Cased _____ in., _____ ft.

Sand _____

Gas _____

Oil _____

Total Depth _____

PRODUCTION

1st 24 hrs. Nat. _____

1st 24 hrs. after shot _____

Gas _____ Cu. Ft.

Dry Hole _____

Abandoned _____

Date

9/26 1920

Pyle

Scout

Map No. K11 Sec. 18 Twp. 29 R. 6Well No. 2 ParmenterMid-Kansas Company

Contractor

SECTION PLAT

		0	
COMPLETED			

Ft. from N. Line

1120 Ft. from S. Line

Ft. from E. Line

200 Ft. from W. Line

Location

Rig up

Drilling and Remarks:

Shot 60 gts

RECORD

Cased _____ in., _____ ft.

Sand 2808-29

Gas _____

Oil _____

Total Depth _____

PRODUCTION

1st 24 hrs. Nat. _____

1st 24 hrs. after shot 100

Gas _____ Cu. Ft.

Dry Hole _____

Abandoned _____

Date

1/27 1921 HBP Scout