


Section 30 Township 14 Range 13W

Well No. #24 E. Miller

Company Jayhawk Well Service

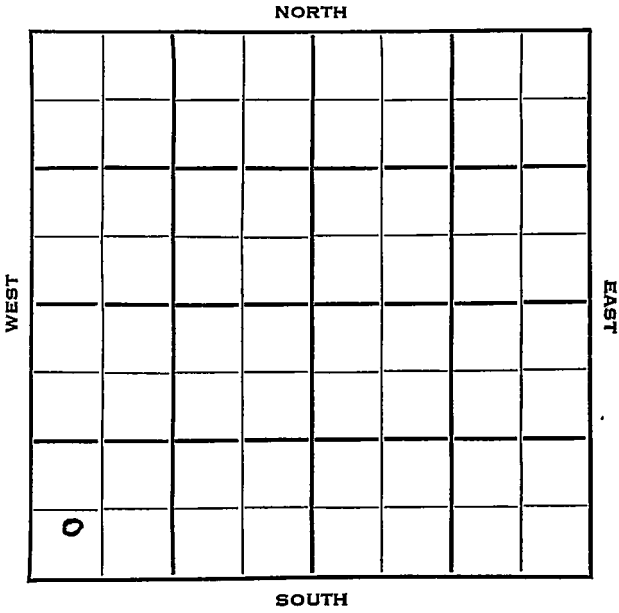


Russell

KANSAS ✓

Sec. 30 Twp. 14 R. 13WWell No. #24 E. Miller FarmJayhawk Well Service CompanyJayhawk ContractorHall-Gurney Pool Ft. from N. Line495 Ft. from S. Line Ft. from E. Line380 Ft. from W. Line

NW SW SW SW

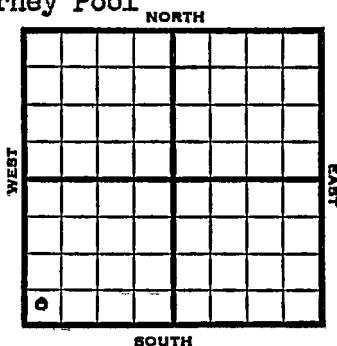

1953

Elev. 1744'

REPORT

7/22

Spud 7-19-53

15" @ 34'

Drlg 40'

7/29

8" @ 710

Drlg. 1180'

8/5

Drlg. 2085'

8/12

1st Tarkio 2270'

7" @ 2319

8/19

Spud 7-19-53

Oil well TD 2319

15" @ 34'

8" @ 710

1st Tarkio 2270'

7" @ 2319

TD 2319

Perf 2269-76

Hydro. S/8 BOPH

Comp. 50 BOPD

COMPLETED

County Russell State Kansas
 Sec. 30 (Blk. Twp.) 14 (Sur. Rge.) 13W Map No. _____
 Operator Jayhawk Well Service
 Well No. 24 Farm E. Miller
 Elev. _____ Location NW SW SW SW

FIRST REPORT

495 Ft. From S Line SW
330 Ft. From W Line Quarter
 1st. Report JUL 22 1953
 Completion _____
 Remarks _____
Jayhawk - Contr.
 Spudding Date 7-19-53

Drlg. Data Hall-Gurney Pool
15" @ 34 drlg. 40

J. G. McGEHEE

