

KANSAS

Barton

FORM 51 5M 4-41 PETROL

Section 19 Township 16 Range 13-W

Well No. #2 Susank

Company Continental

Trapp Pool

NORTH

WEST

EAST

					0	.	

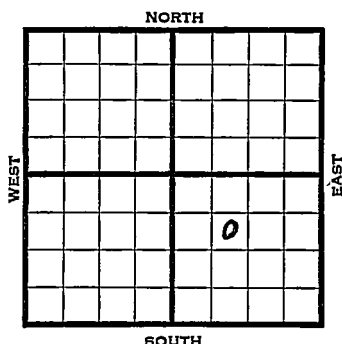
SOUTH

KANSAS

Barton

Sec. 19 Twp. 16 R. 13-WWell No. #2 Susank FarmContinental Company

(Trapp)

990 Ft. from N. Line Ft. from S. Line Ft. from E. Line990 Ft. from W. Line*Elv. 1949*

1942	REPORT
6/3	10" - 360' WOC.
6/10	Drlg. 2495'
6/17	Arb. 3382-85' T.D. Run 5".
6/24	7" - 3383' T.D. 3400'
	200' oil 16 hours.
7/1	500 acid. 2000' oil - 4000 acid.
7/8	P. B.
7/15	P.B. to 3398' 500 acid. 800' oil & 200' water. P.B. to 3396'
7/22	T.D. 3400' 250 acid. 2275' oil plus 125' water.
7/29	" "
8/5	500 acid 2400' oil & 180' water.
8/12	Arb. 3382 7" - 3383 T.D. 3400 P.B. 3395 850 acid Pump 372 oil & 77 water Pot. Gravity 39.
	COMPLETED

Barton

KANSAS

Map No. 73 Sec. 19 Twp. 16 R. 13WWell No. 2 SusankContinental

Company

FIRST REPORT

Contractor

SE NW SE

SECTION PLAT

990 Ft. from N. Line

 Ft. from S. Line Ft. from E. Line990 Ft. from W. Line

TRAPP POOL

Location

RECORD

Cased in., ft.Rig up Sand

Drilling and Remarks:

Gas 10" - 360'Oil Total Depth Waiting on
cement to set

PRODUCTION

1st 24 hrs. Nat. 1st 24 hrs. after shot Gas Cu. Ft.Dry Hole Abandoned

Date

JUN 3 1942 19S. J. LEWIS Scout

Map No. 73 Sec. 19 Twp. 16 R. 13WWell No. 2 SusankContinental

Company

COMPLETED

Contractor

SECTION PLAT

SE NW SE

990 Ft. from N. Line

Ft. from S. Line

Ft. from E. Line

990 Ft. from W. Line

TRAPP POOL

RECORD

Location

Cased _____ in., _____ ft.

Rig up

Sand _____

Drilling and Remarks:

Gas _____

Oil _____

Total Depth 3400

PRODUCTION

1st 24 hrs. Nat. _____

1st 24 hrs. after shot _____

Gas _____ Cu. Ft.

Dry Hole _____

Abandoned _____

Date

AUG 12 1942

19

S. J. LEWIS

Scout

CR 8382
7" C 3383
PB 3385
500 cu
Pump 372 oil +
77 Water 20
39 cu