

Russell


KANSAS

FORM 51 5M 4-41 PETROL

Section 30 Township 14 Range 13W

Well No. 26 E. Miller

Company J. J. Hall

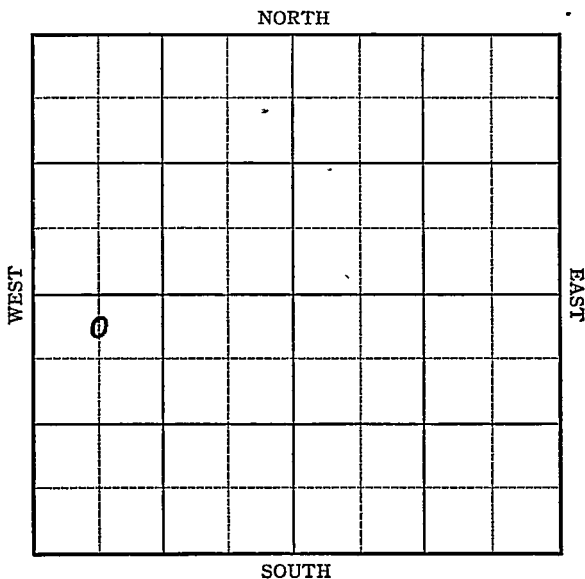


Sec. 30 Twp. 14 R. 13-WWell No. #26 E. Miller FarmJ. J. Hall Company

(Hall Gurney)

330 Ft. from N. Line Ft. from S. Line Ft. from E. Line660 Ft. from W. Line

Elev. 1764

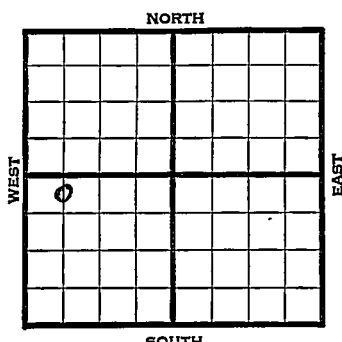

1941	REPORT
7/16	10" - 125' Anhy. 710'
	Drlg. 845'
7/24	D. lg. 2590
7/31	Lansing 2870 ' 2890
	5" @ 2870 RUST
8/7	TD 2880' SD
8/15	Lans. 2890 (Corrected)
	5" -2900 T.D. 2925 RUST
	Bail $\frac{1}{4}$ BO PH natural
	1000 acid.
8/21	T.D. 2995' 4000 acid.
8/27	Lans. 2870'
	5" - 2900'
	T.D. 2955'
	5000 acid.
	Potential 1609 bbls., pump.
	38.3 Gravity
	COMPLETED

Map No. 72 Sec. 30 Twp. 14 R. 13WWell No. 26 E. MillerJ. J. Hall

Company

Contractor

FIRST REPORT

SECTION PLAT

C N L NW SW

330 Ft. from N. Line

Ft. from S. Line

Ft. from E. Line

660 Ft. from W. Line

o			

HALL GURNEY POOL

RECORD

Location _____

Cased _____ in., _____ ft.

Rig up _____

Sand _____

Drilling and Remarks:

Gas _____

10" - 125

Oil _____

Total Depth _____

Anhy. 710

PRODUCTION

Drilg. 845

1st 24 hrs. Nat. _____

1st 24 hrs. after shot _____

Gas _____ Cu. Ft.

Dry Hole _____

Abandoned _____

Date

JUL 16 194119S. J. LEWIS

Scout

Map No. _____ Sec. 30 Twp. 14 R. 13WWell No. 26 E. MillerJ. J. Hall

Company _____

Contractor _____

COMPLETED**SECTION PLAT**

C N L NW SW

0			

330 Ft. from N. Line

_____ Ft. from S. Line

_____ Ft. from E. Line

660 Ft. from W. Line

HALL GURNEY POOL

Location _____

Rig up _____

Drilling and Remarks:

*L. and 2870**5" @ 2900**5000 acut**Pump 1609 BT**38° S***RECORD**

Cased _____ in., _____ ft.

Sand _____

Gas _____

Oil _____

Total Depth 2855**PRODUCTION**

1st 24 hrs. Nat. _____

1st 24 hrs. after shot _____

Gas _____ Cu. Ft.

Dry Hole _____

Abandoned _____

Date

AUG 27 1941 19S. I. LEWIS

Scout