


Section 30 Township 14 Range 13-W

Well No. #1 Hickey

Company Skelly Oil

NORTH Hall Pool

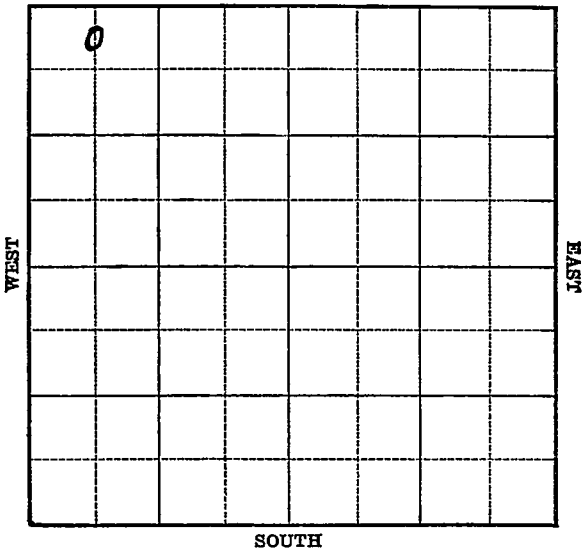

Sec. 30 Twp. 14 R. 13-W

Well No. #1 Hickey Farm

Skelly Oil Company

(Hall)


330 Ft. from N. Line

_____ Ft. from S. Line

_____ Ft. from E. Line

660 Ft. from W. Line

Elev. 1724

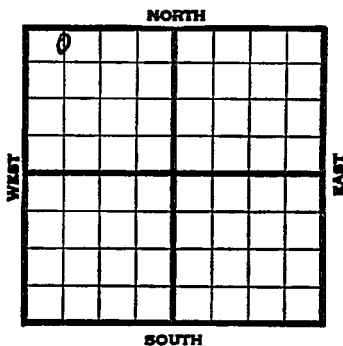

| 1940 | REPORT |
|------|------------------------------|
| 2/21 | Location |
| 2/29 | Derrick. |
| 3/8 | 10" - 294' Drlg. 1430' |
| 3/14 | Drlg. 2625' |
| 3/21 | Lans. 2850' 7" - 2870' |
| | T.D. 2893' 400' oil 4 hours. |
| 3/28 | 7000 acid. Pump 29 bbls. 1/2 |
| | hour. |
| 4/3 | Lans. 2850' |
| | 7" - 2870' |
| | T.D. 2891' |
| | 7000 acid. |
| | Potential 1386 bbls., pump. |
| | COMPLETED |
| | |
| | |
| | |
| | |
| | |
| | |

Map No. 72 Sec. 30 Twp. 14 R. 13WWell No. 1 HickeySkelly Oil

Company

Contractor

FIRST REPORT

C N L NW NW

330 Ft. from N. Line

_____ Ft. from S. Line

_____ Ft. from E. Line

660 Ft. from W. Line

SECTION PLAT

| | | | |
|---|--|--|--|
| 0 | | | |
| | | | |
| | | | |
| | | | |

HALL POOL

Location X

Rig up _____

Drilling and Remarks:

RECORD

Cased _____ in., _____ ft.

Sand _____

Gas _____

Oil _____

Total Depth _____

PRODUCTION

1st 24 hrs. Nat. _____

1st 24 hrs. after shot _____

Gas _____ Cu. Ft.

Dry Hole _____

Abandoned _____

Date

FEB 21 1940

19

S. J. LEWIS

Scout

Map No. 72 Sec. 30 Twp. 14 R. 13W

Well No. 1 Hickey

Skelly Company

Contractor

COMPLETED
C N L NW NW

330 Ft. from N. Line

_____ Ft. from S. Line

_____ Ft. from E. Line

660 Ft. from W. Line

SECTION PLAT

| | | | |
|---|--|--|--|
| o | | | |
| | | | |
| | | | |
| | | | |

HALL POOL

Location _____

Rig up _____

Drilling and Remarks:

Lions. 2850
7" @ 2870
7000 acid
Pump 1386 BX

RECORD

Cased _____ in., _____ ft.

Sand _____

Gas _____

Oil _____

Total Depth 2891

PRODUCTION

1st 24 hrs. Nat. _____

1st 24 hrs. after shot _____

Gas _____ Cu. Ft.

Dry Hole _____

Abandoned _____

Date

APR 3 1940₁₉

S. J. LEWIS Scout