


Russell

KANAS

SECTION 30 TOWNSHIP 14 RANGE 13W

WELL NO. #15 Phinney

COMPANY C. R.A.

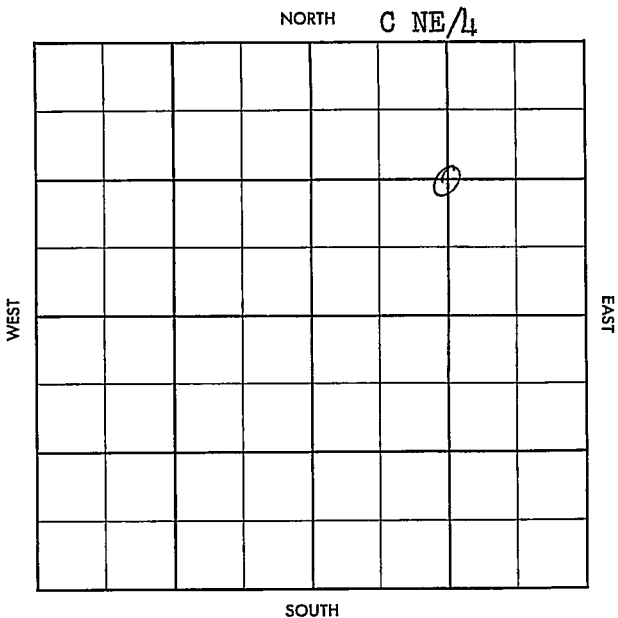

County Russell Elev. \_\_\_\_\_  
 Sec. 30 Twp. 14 Rgs. 13W  
 Company C. R. A.  
 Farm Name Phinney No. 15

Co.

TOPS	DEPTH	LOG	DATUM
Anh.			
Tr.			
H.			
Tr.			
Dg.			
Bl.			
L.			
K.C.			
B.K.C.			
Ce.			
C.			
M.			
M.			
K.			
Mz.			
Mo.			
V.			
S.			
S.			
A.			
R.			
PE.			
G.			
T.D.			

Loc. in Sec. \_\_\_\_\_  
C NE/4  
150' NE

Geol. \_\_\_\_\_  
 Contr. \_\_\_\_\_  
Shields Drl

Pool \_\_\_\_\_  
Hall-Gurney


MAY 15 57

FIRST REPORT

1568

Ho.

Date Comm. \_\_\_\_\_  
 Location \_\_\_\_\_


Sec.

T.

R.



County Russell Elev. 1765  
 Sec. 30 Twp. 14 Rge. 13W  
 Company G. R. A.  
 Farm Name Phinney No. 15

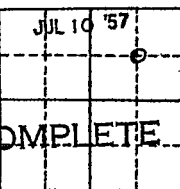TOPS	DEPTH	LOG	DATUM	Loc. in Sec.
Anb. <u>h</u>	<u>700</u>			<u>C NE/4</u>
TP. <u>Tarkli</u>	<u>2326</u>			
H. <u>elm</u>	<u>2394</u>			<u>150' NE</u>
Tr. <u>TD</u>	<u>2604</u>			
Dg. <u>H6</u>	<u>2833</u>			
Bl. <u>TR</u>	<u>2851</u>			
L. <u></u>	<u>2900</u>			
K.C.				Geol. <u></u>
B.K.C.				Contr. <u></u>
Ce.				
C.				<u>Shields Drl</u>
M.				
M.				Pool <u></u>
K.				
Mz.				<u>Hall-Gurney</u>
Ma.				
V.				
S.				
S.				
A.				
R. <u>sd</u>	<u>3171</u>			<div style="border: 1px solid black; padding: 5px; text-align: center;">                 JUL 10 '57                    COMPLETE             </div>
PE.				
G.				
TD.	<u>3173</u>			

Date Comm. Location MAY 22 '57 MAY 23 '57 5-28-57  
Ø 520 JUN 5 '57 8 5/8 210/400  
Ø 2925 JUN 12 '57 5 1/2 @ 3172/100  
CO 3173 TD FU 2285' oil in  
2 hrs FU 2573' oil in 5 hrs  
+ Tr. wt. JUN 19 '57 POP. P. 42  
DO n/w 1 hr JUN 26 '57 P: 100  
BO + 28 BW 24 hrs JUN 26 '57  
P. 90 DO + 23 BW 21 hrs JUL 10 '57  
est P. 25 Bopd + 10 BWpd