


Section 30 Township 14 Range 13W

Well No. #6 Hickey

Company Skelly

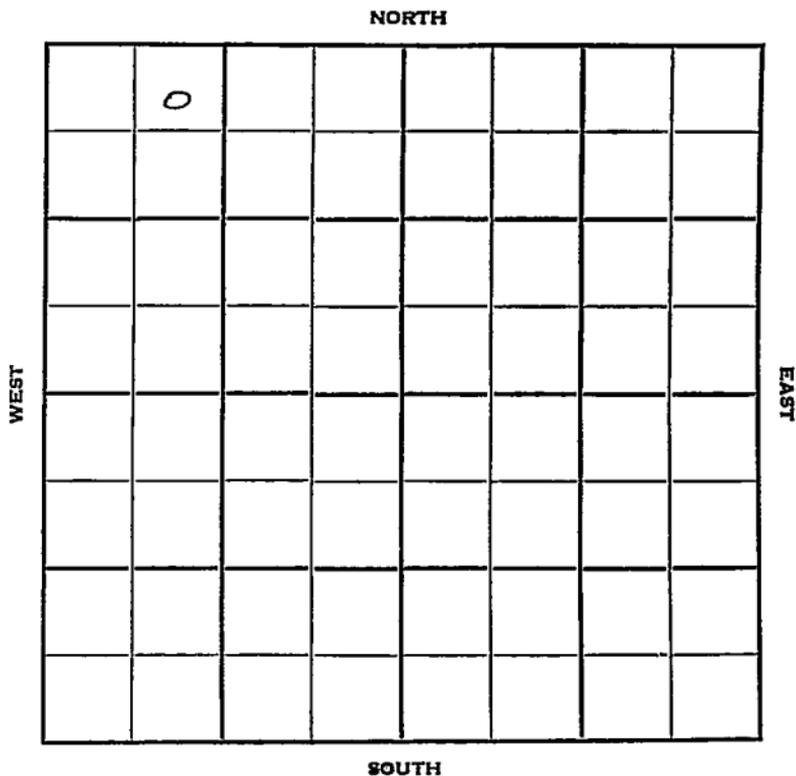

Russell

KANSAS

Sec. 30 Twp. 14 R. 13W

Well No. #6 Hickey Farm

Skelly Company

Wentworth Contractor

Hall Gurney


330 Ft. from N. Line

\_\_\_\_\_ Ft. from S. Line

\_\_\_\_\_ Ft. from E. Line

990 Ft. from W. Line

NE NW NW

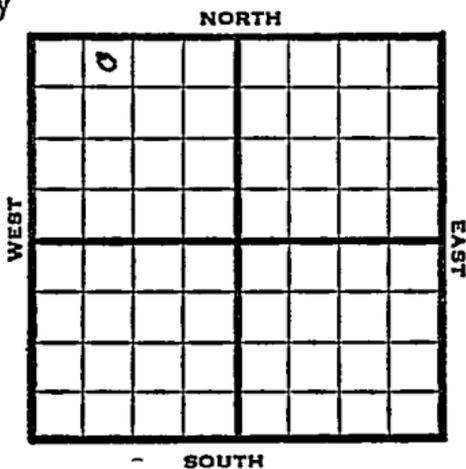

1952 Elev. 1721' REPORT

3/26 RUR  
4/1 10" @ 195'  
Drlg. 2100'  
4/9 Indian Cave sd 2243  
RTD 2252  
7" @ 2248 WOC  
4/23 DP DD 2259' 1 Bbl A Test  
12 gal OPH. 10/2247-52'  
12 gal OPH DD 2260' TD 3-Hyd  
P/97 BO 15 hrs.  
4/30 Spud 3-24-52  
Oil well TD 2260' 10" @ 195'  
Indian Cave sand 2243'  
TD 2252' 7" @ 2248' DD 2259'  
12 GOPH 10/2247-52 12 GOPH  
DD 2260 Hydro P/96 BO 15 hr.  
Comp. 55 BOPD 5 BW

COMPLETED

County **Russell** State **Kansas**

Sec. **30** (Blk. **14**) (Sur. Rge.) **13W** Map No.

Operator **Skelly**

Well No. **6** Farm **Hickey**

Elev. Location **NE NW NW**

0					

**330** Ft. From **N** Line **NW**

**990** Ft. From **W** Line Quarter

Ist. Report **MAR 26 1952**

Completion

Remarks

**Wentworth - Contr.**

Spudding Date

Drig. Data **Hall Gurney**

**RUR**

County Russell State Kansas

Sec. 30 (<sup>Blk.</sup><sub>Twp.</sub>) 14 (<sup>Sur.</sup><sub>Rge.</sub>) 13W Map No.

Operator Skelly Oil

Well No. 6 Farm Hickey

Elev. 1721 Location NE NW NW

o					

**COMPLETE**

330 Ft. From N Line NW

990 Ft. From W Line Quarter

Ist. Report

Completion APR 30 1952

Remarks Hall-Gurney Pool

Wentworth - Contr.

Spudding Date 3-24-52

Drlg. Data Oil well TD 2260

10" @ 195 Indian cave sand 2243

TD 2252 7" @ 2248 DD 2259 12 goph

10/ 2247-52 12 goph DD 2260

Hydro. P/ 96 bo 15 hr.

Comp. 55 bopd 5 bw