


Section 19 Township 16 Range 13W

Well No. #5, Susank

Company Skelly




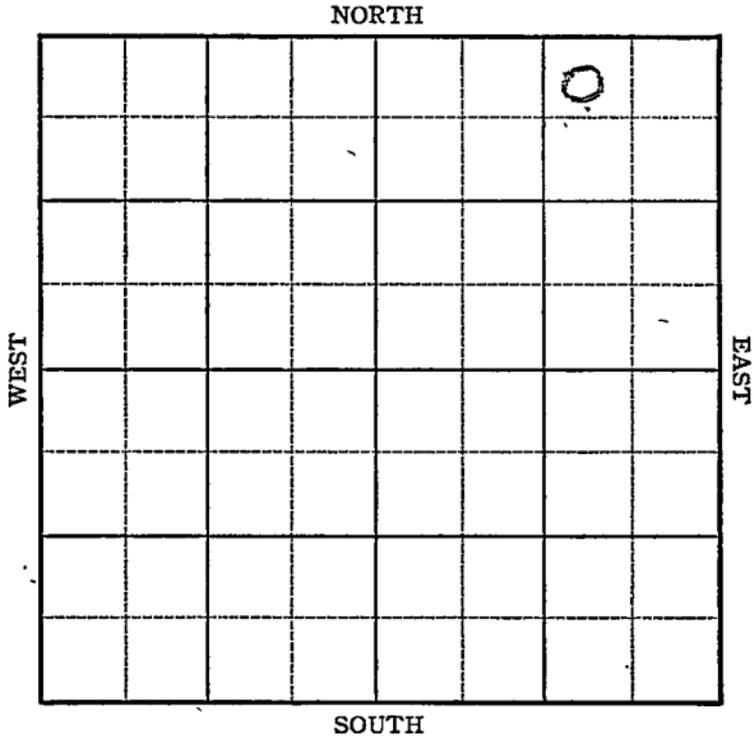

Sec. 19 Twp. 16 R. 13W

Well No. #5 Susank Farm \_\_\_\_\_  
Skelly Company \_\_\_\_\_

Susank  
330 Ft. from N. Line  
\_\_\_\_\_ Ft. from S. Line  
990 Ft. from E. Line  
\_\_\_\_\_ Ft. from W. Line

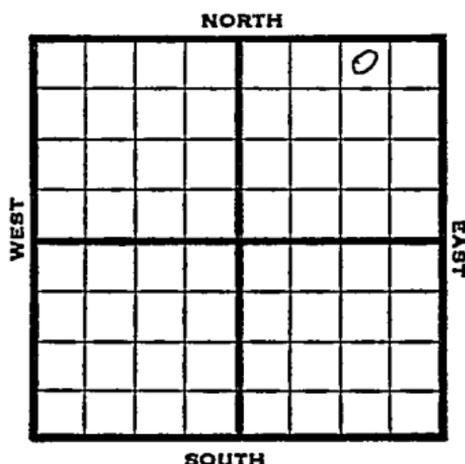

NW NE NE

1946

Elev. 1944

REPORT

4/3

RUR

4/10

Anhy 885

8" @ 890

Drlg 1385

4/16

Drlg 3360

4/23

Lans 3147

Arb 3386-5" @ 3387

TD 3392

swb 50 oil in 19 hrs

5/1

Arb. 3386

5" @ 3387

500 acid.

TD 3392

Pump 216 Pot.

Grav. 37.0

COMPLETED

**KANSAS** Kansas Pool Name Susank

Map No. 73 Sec. 19 Twp. 16 R. 13W

Well No. 5 Susank

Skelly Company

FIRST REPORT Contractor  
NW NE NE

330 Ft. from N. Line

\_\_\_\_\_ Ft. from S. Line

990 Ft. from E. Line

\_\_\_\_\_ Ft. from W. Line

**SECTION PLAT**

			0

Barton County

Location \_\_\_\_\_

Rig up \_\_\_\_\_

Drilling and Remarks:

R U R

**RECORD**

Cased \_\_\_\_\_ in., \_\_\_\_\_ ft.

Sand \_\_\_\_\_

Gas \_\_\_\_\_

Oil \_\_\_\_\_

Total Depth \_\_\_\_\_

**PRODUCTION**

1st 24 hrs. Nat. \_\_\_\_\_

1st 24 hrs. after shot \_\_\_\_\_

Gas \_\_\_\_\_ Cu. Ft.

Dry Hole \_\_\_\_\_

Abandoned \_\_\_\_\_

Date

APR 3 1946 19

S. J. LEWIS Scout

**KANSAS**

Kansas Pool Name Susank Pool

Map No. 73 Sec. 19 Twp. 16 R. 13W

Well No. 5 Susank

Skelly Company

**COMPLETEL** Contractor

NW NE NE

*E 11944*  
SECTION PLAT

			0

330 Ft. from N. Line

\_\_\_\_\_ Ft. from S. Line

990 Ft. from E. Line

\_\_\_\_\_ Ft. from W. Line

Barton County

Location \_\_\_\_\_

Rig up \_\_\_\_\_

Drilling and Remarks:

*CR 70386*  
*5" @ 3387*  
*500 acid*  
*Pump 216*

*37 = 1/2*

**RECORD**

Cased \_\_\_\_\_ in., \_\_\_\_\_ ft.

Sand \_\_\_\_\_

Gas \_\_\_\_\_

Oil \_\_\_\_\_

Total Depth 3392

**PRODUCTION**

1st 24 hrs. Nat. \_\_\_\_\_

1st 24 hrs. after shot \_\_\_\_\_

Gas \_\_\_\_\_ Cu. Ft.

Dry Hole \_\_\_\_\_

Abandoned \_\_\_\_\_

Date

MAY 1 1946 19

S. J. LEWIS Scout