Form 51-5M-12-36 Com'l


Russell

KANSAS

Section 31 Township 14 Range 13-W

Well Number 12 Guy Miller

Company Smokey Hill

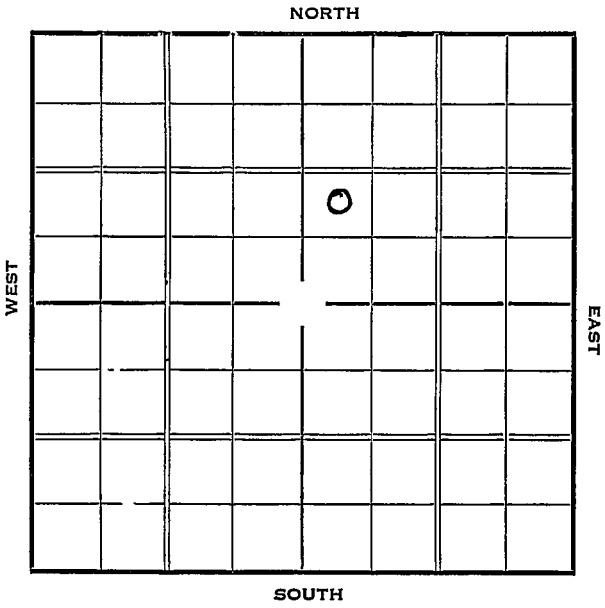


Form 252-A—5M—2-37—Palace KANSAS Russell

Sec. 31 Twp. 14 R. 13-W

Well No. ~~#~~ Guy Miller #2 Farm

Smokey Hill Company

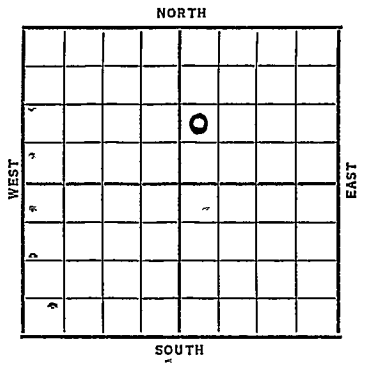

____ Ft. from N. Line

990 Ft. from S. Line

____ Ft. from E. Line

330 Ft. from W. Line

Elev. 1710

Date	REPORT
1937	
4/14	Location
4/30	Rig
5/7	"
5/14	Rig'n up cable tools.
5/21	15" @ 95'. T.D. 197' Esg.
5/28	" " " " "
6/4	Drlg. 650'.
6/11	12" @ 200'. 10" @ 268'.
	Drlg. 1775'.
6/19	8" @ 2335'. Drlg. 2348'.
6/25	K.C. 2854'. 6" @ 2860'.
	WOC.
7/2	S. O. 2869-70 & 2910-17'.
	T.D. 2953'. P.B. 2941'.

OVER

1937

7/7 6" @ 2860'.

K.C. 2854'.

T.D. 2953'.

P.B. 2939'.

8000 acid.

Pot. 1071 bbls.

COMPLETED

Form 26—1M Bks.—2-29 KANSAS Russell


Map No. _____ Sec. 31 Twp. 14 R. 13W

Well No. 7 Guy Miller

Amerada Petroleum Company

_____ Contractor

SECTION PLAT

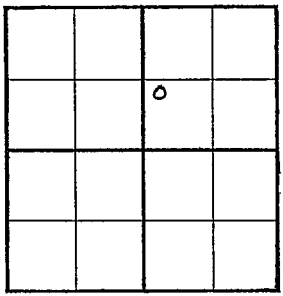

_____ Ft. from N. Line

990 Ft. from S. Line

_____ Ft. from E. Line

330 Ft. from W. Line

FIRST REPORT

Location ✓

Rig up _____

Drilling and Remarks:

RECORD

Cased _____ in., _____ ft.

Sand _____

Gas _____

Oil _____

Total Depth _____

PRODUCTION

1st 24 hrs. Nat. _____

1st 24 hrs. after shot _____

Gas _____ Cu. Ft.

Dry Hole _____

Abandoned _____

Date

APR 14 1937 19

S. J. LEWIS Scout

Form 26—1M Bks —2-29 Russell KANSAS

Map No. 72 Sec. 31 Twp. 14 R. 13 W

Well No. 12 - Guy Miller

Smokey Hill Company

Contractor

CORRECTION


Ft. from N. Line

990 Ft. from S. Line

Ft. from E. Line

330 Ft. from W. Line

SECTION PLAT

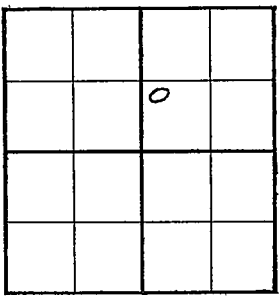

Location

Rig up

Drilling and Remarks:

first reported as being #7.

RECORD

Cased in., ft.

Sand

Gas

Oil

Total Depth

PRODUCTION

1st 24 hrs. Nat.

1st 24 hrs. after shot

Gas Cu. Ft.

Dry Hole

Abandoned

Date

JUN 9 1937 19

H. D. Hatfield Scout

Form 26—1M Bks.—2-29 Russell KANSAS

Map No. ____ Sec. 31 Twp. 14 R. 13 W


Well No. 12 Guy Miller

Smokey Hill Company

Contractor

COMPLETED

SECTION PLAT

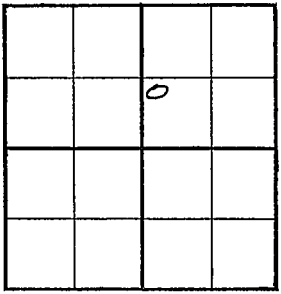

____ Ft. from N. Line

990 Ft. from S. Line

____ Ft. from E. Line

330 Ft. from W. Line

Location ____

Rig up ____

Drilling and Remarks:

P.B. 2939

8000-A

Pot - 1071

RECORD

Cased 6 in., 2860 ft.

~~Sand~~ K.C. 2854

Gas ____

Oil ____

Total Depth 2953

PRODUCTION

1st 24 hrs. Nat. ____

1st 24 hrs. after shot ____

Gas ____ Cu. Ft.

Dry Hole ____

Abandoned ____

Date

JUL 7 1937 19____ H. D. Hatfield Scout