Form 51—5M—3-35—Mid-West


Russell

Map No. KANSAS Sec. 30 Twp. 14 R. 13 W

Well No. 3- Miller Farm

Russell Oil Co (Hall) Company

NORTH

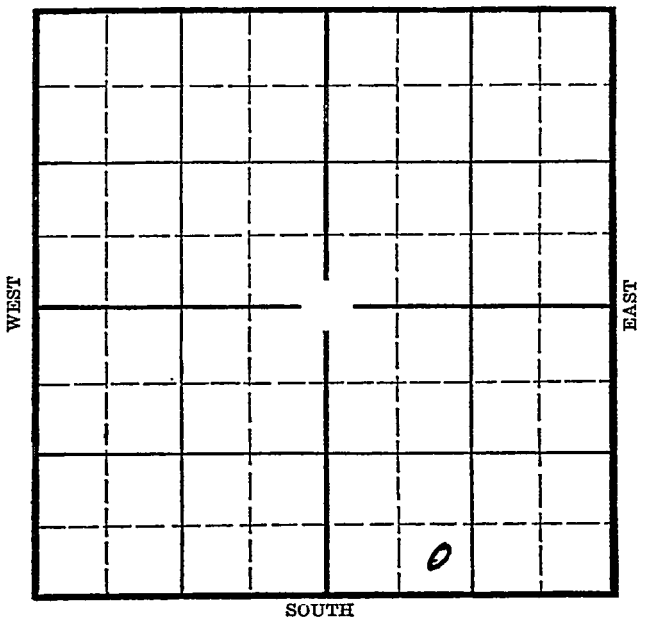

Location

Drilling Remarks

Rig Up

Drilling Remarks

RECORD

Cased ____ in. ____ ft.

Sand

Gas

Oil

Total Depth

PRODUCTION

1st 24 hrs. Nat.

1st 24 hrs. after shot

Gas ____ cu. ft.

Dry Hole

Abandoned


Form 252-A
5M 7-34 MPC

Russell

Map No. KANSAS Sec. 30 Twp. 14 R. 13W

Well No. 3- Miller Farm

Russell Oil Co (Hall) Company

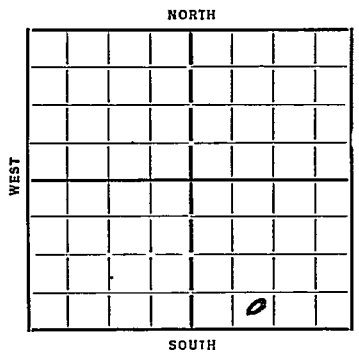

_____ Ft. from N. Line

330 Ft. from S. Line

_____ Ft. from E. Line

990 Ft. from W. Line

Elev. 1750

Date	REPORT
1935	
5/22	Moving
5/29	—
6/6	Rgm
6/13	15" 372 Rep Rig 390
6/20	Anhy & 10" 683
	Shy 1475
6/28	" 2013 Ahs Gas 1886
7/3	Shy 2272 Sh 2443
	8" 2290 Shy 2445
7/11	Oswald 2877 T.D. 2975
	2000 Gal Acidize
7/18	60 Bbls per hr.
7/31	Top Oswald 2877
	T. D. 2975
	1000 acid
	2000 acid
	725 oil
	COMPLETED

Form 26—1M Blk. 9-28

Russell

Map No. 72 Sec. 30 Twp. 14 R. 13W


Well No. 3-Miller

Russell Oil (Hall) Company

Contractor

COMPLETED

SECTION PLAT

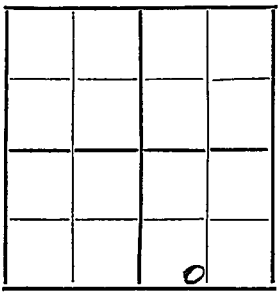

..... Ft. from N. Line

330 Ft. from S. Line

..... Ft. from E. Line

990 Ft. from W. Line

Location.....

Rig up.....

Drilling and Remarks:

1000 acid
2000 acid

725 bbls

RECORD

Cased ..... in., ... ft.

Sand Arnold 2877

Gas.....

Oil.....

Total Depth 2975

PRODUCTION

1st 24 hrs. Nat.....

1st 24 hrs. after shot.....

Gas..... Cu. Ft.

Dry Hole.....

Abandoned.....

Date

7-31-35 192.....

ORVAL MANNSCHRECK

Scout

Form 26—M.B.A. 2-28 Russell

Map No. 72 Sec. 30 Twp. 14 R. 13W

Well No. 3 Miller

Russell Oil Co (Hall) Company

Contractor

FIRST REPORTS


Ft. from N. Line

330 Ft. from S. Line

Ft. from E. Line

990 Ft. from W. Line

SECTION PLAT

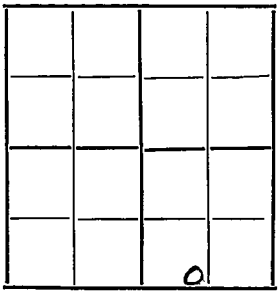

Location

Rig up

Drilling and Remarks:

moving

RECORD

Cased in., ft.

Sand

Gas

Oil

Total Depth

PRODUCTION

1st 24 hrs. Nat.

1st 24 hrs. after shot

Gas Cu. Ft.

Dry Hole

Abandoned

Date

3-27-35 192

ORVAL MARNSCHRECK Scout