

Butler

KANSAS


SECTION 20 TOWNSHIP 29S RANGE 6E

WELL NO. #1 Hammond

COMPANY Augusta Oil Co. C/N/2

NORTH

~~NW~~ SW NE

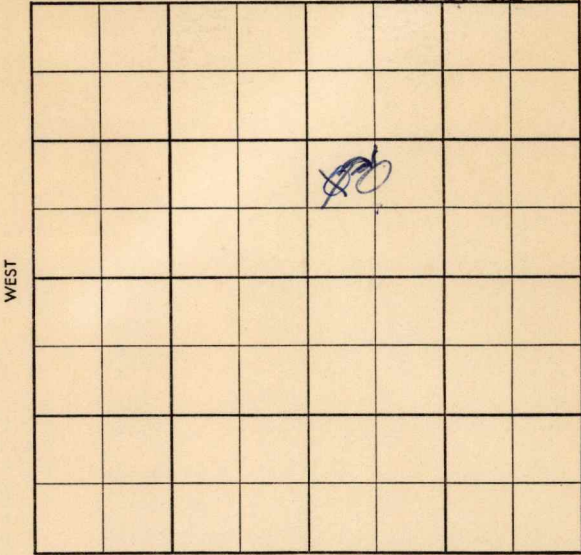

SOUTH

WEST

EAST

# WILDCAT

Twp. ~~X~~ Pool ~~X~~  
 Co. ~~X~~ Facet ~~X~~

S-513-B

County Butler Elev. 1374 est RB  
 Sec. 20 Twp. 29 Rge. 6E  
 Company Augusta Oil Co.  
 Farm Name Hammond No. 1

TOPS	DEPTH	LOG	DATUM
Anh.			
Tp.			
H.			
Tr.			
<del>X</del> <u>Stal</u>	<u>1676</u>		
B.L.			
L.			
K.C.	<u>2162</u>		
B.K.C.			
<del>X</del> <u>Peru</u>	<u>2492</u>		
C.			
M.	<u>2809</u>		
M.			
K.			
Mz.			
Mq.			
V.			
S.			
S.			
A.			
R.			
Pf.			
G.			
T.D.			

Loc. in Sec. App NW SW NE  
↙

Geol.                       
 Contr.                     

Pool Wildcat

FIRST REPORT

APR 2 1958

Date Comm. 3/26/58  
8" @ 200, Stal 1676, SO, DST 2825-31 1 1/2 hr,  
rec. 55' sli OCM 565#/20, RTD 2831, Log 5"  
@ 2826, WOC

Sec. T. R.

Twp. ~~-----~~ Pool ~~-----~~  
 Co. ~~-----~~ Facet ~~-----~~

**CORRECTION**

S-513-B

County Butler Elev. 1374 est RB  
 Sec. 20 Twp. 29 Rge. 1370 DF 6E  
 Company Augusta Oil Co.  
 Farm Name Hammond No. 1

TOPS	DEPTH	LOG	DATUM
Anh.			
Tp.			
H.			
Tr.			
<del>Stg.</del> <u>Stal</u>	<u>1676</u>		
B.L.			
L.			
K.C.	<u>2162</u>		
<del>B.K.C.</del> <u>Peru</u>	<u>2492</u>		
C.			
M.	<u>2809</u>		
M.			
K.			
Mz.			
Mq.			
V.			
S.			
S.			
A.			
R.			
Pf.			
G.			
T.D.			

Loc. in Sec. App NW SW NE  
C N/2 SW NE  
 Geol. Wildcat  
 Contr. Wildcat  
 Pool Wildcat  
**ABANDONED**  
 APR 30 '58

Date Comm. 3/26/58  
8" @ 200, Stal 1676, 30, DST 2825-31 1 1/2 hr,  
rec. 55' sli OCM 565#/20, RTD 2831, Log 5"  
@ 2826, WOC APR 9 '58 APR 16 '58 CDD 2834  
PB 2033 A \$ 1590 NW 12 hrs  
PB APR 30 '58 40/1776-86  
12 hrs  
D+A

Co. Sec. No. Sec. T. R.