


DX 78-1 Butler

KANSAS

Section 21 Township 29 Range 6E

Well No. #1 Price

Company Bill Braden Drlg

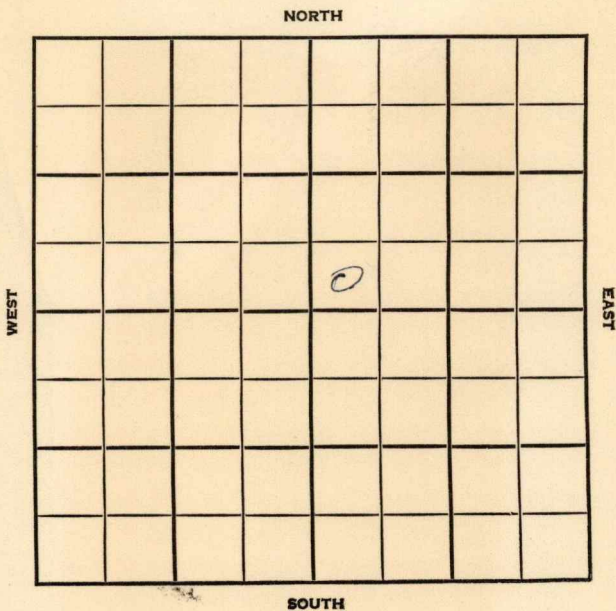

SEC. 21	TWP. 29	R. 6E
------------	------------	----------


WELL NO. #1 Price FARM

COMPANY Bill Braden Drlg.

CONTRACTOR Co. Tools

Steinhoff Ext.

_____ FT. FROM N. LINE
 _____ FT. FROM S. LINE
 _____ FT. FROM E. LINE
 _____ FT. FROM W. LINE

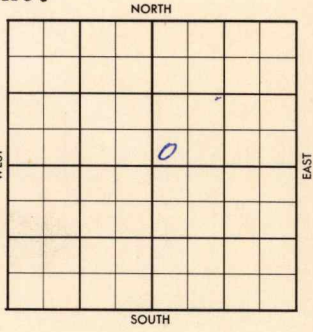

SW SW NE

1956	ELEVATION 1322'	REPORT
------	--------------------	--------

6-6 Comm. 6-3-56
 7-18 13" @ 880
 10" @ 6565
 8 5/8" @ 2062
 5 1/2" @ 2757
 D & A
 Bartl Sd 2757
 M. 2757
 A. 3054
 TD 3080'

ABANDONED

County Butler Elev. 1322
 Sec. 21 Twp. 29 Rge. 6E
 Company Bill Braden Drlg.
 Farm Name Price No. 1

TOPS	DEPTH	LOG	DATUM	Loc. in Sec.						
Anh.				SW SW NE						
TP.										
H. <u>Bart 5d</u>	<u>2757</u>	<u>(SSO)</u>								
Tr.										
Dg.										
Bl.										
L.				Geol.						
K.C.				Contr.						
B.K.C.				Co. tools						
Ce.				Pool						
C.				Steinhoff Ext.						
M.	<u>2757</u>			<table border="1"> <tr> <td colspan="2">ABANDONED</td> </tr> <tr> <td></td> <td>0</td> </tr> <tr> <td>JUL 18</td> <td>1956</td> </tr> </table>	ABANDONED			0	JUL 18	1956
ABANDONED										
	0									
JUL 18	1956									
M.										
K.										
Mz.										
Mo.										
V.										
S.										
S.										
A.	<u>3054</u>									
R.										
PE.										
G.										
TD.	<u>3080</u>									

Date Comm. 6-3-56 JUN 13 '56 13" @ 1565 JUN 27 '56
~~13" @ 1565~~
9 1/8 @ 2062 JUN 20 '56 10" @ 1565 JUN 27 '56
8 5/8 @ 2062 10" @ 1565 JUN 3 '56
2575 JUL 11 '56 5 1/2 @ 2757
2925 JUL 18 '56

DEA

County Butler Elev. _____
 Sec. 21 Twp. 29 Rgs. 6E
 Company Bill Braden Drlg.
 FarmName Price No. 1

TOPS	DEPTH	LOG	DATUM
Anh.			
TP.			
H.			
Tr.			
Dg.			
Bl.			
L.			
K.C.			
B.K.C.			
Ce.			
C.			
M.			
M.			
K.			
Mz.			
Me.			
V.			
S.			
S.			
A.			
R.			
PE.			
G.			
T.D.			

Loc. in Sec. SW SW NE
 Geol. _____
 Contr. Co. tools
 Pool Steinhoff Ext.

FIRST REPORT
 JUN 6 '56

Date Comm. 6-3-56

JUN 11 1956
 R. G.

Co.
 Lse.
 No.
 Sec.
 T.
 R.