


Map No. 141 Sec. 21 Twp. 29 R. 6

Well No. 1 Steinhoff Farm

Garden & White Eagle Company

NORTH

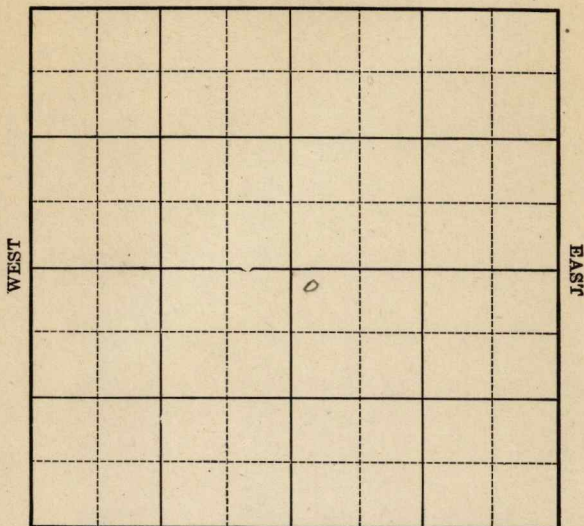

SOUTH

Location

Drilling Remarks

Rig Up

Drilling Remarks

RECORD

Cased _____ in. _____ ft.

Sand _____

Gas

Oil

Total Depth

PRODUCTION

1st 24 hrs. Nat. _____

1st 24 hrs. after shot

Gas _____ cu. ft

Dry Hole_____

Abandoned

Butler Co

Map No. Kansas Sec. 21 Twp. 29 R. 6Well No. 1 Steinhoff FarmGarden & White Eagle Company

NORTH

WEST

EAST

SOUTH

200 Ft. from N. Line

_____ Ft. from S. Line

_____ Ft. from E. Line

200 Ft. from W. Line

Date

REPORT

192511/27Bldg Rig12/3Rig12/10—12/17—12/23Rigging up12/31Spudling19261/8—1/14Running 12" 890'1/30Drlg 1240'1/27✓ 1600'2/4S.D. 1600'2/10Dlg 1240'2/17✓ 2080 H.F.W.2/24✓ 22203/5Running 5" 27303/10Slg 2900'3/18Abandoned 3148

K 11
 Map No. **KANSAS** Sec. *21* Twp. *29* R. *6*
 Well No. *1 Steinhoff*
Pardner & White Eagle Company
 Contractor

SECTION PLAT

		o	

200 Ft. from N. Line

_____ Ft. from S. Line

_____ Ft. from E. Line

200 Ft. from W. Line

FIRST REPORTS

Location _____

Rig up _____

Drilling and Remarks:

Blag Rig

RECORD

Cased _____ in., _____ ft.

Sand _____

Gas _____

Oil _____

Total Depth _____

PRODUCTION

1st 24 hrs. Nat. _____

1st 24 hrs. after shot _____

Gas _____ Cu. Ft.

Dry Hole _____

Abandoned _____

Date

NOV 27 1925

CHAS. L. SHERWOOD

192

Scout

K11 **KANSAS** *Butler*
 Map No. *21* Sec. *29* Twp. *6* R. *6*
 Well No. *1* *Stin hoff*
Sutton & White Eagle Company
 Contractor

COMPLETED

SECTION PLAT

200 Ft. from N. Line
 Ft. from S. Line
 Ft. from E. Line
200 Ft. from W. Line

		0	

ABANDONED

Location

Rig up

Drilling and Remarks:

Tap line 2725
Tap Wilcox 3136-
3145'
Dry & abd
20 3148'

RECORD

Cased _____ in., _____ ft.

Sand _____

Gas _____

Oil _____

Total Depth *3148*

PRODUCTION

1st 24 hrs. Nat. _____

1st 24 hrs. after shot _____

Gas _____ Cu. Ft.

Dry Hole ☒Abandoned ☒

Date

MAR 18 1926

CHAS. L. SHERWOOD

192

Scout