


Russell

KANSAS

Section 30 Township 14 Range 13-W

Well Number 8 Miller

Company Smokey Hill Oil

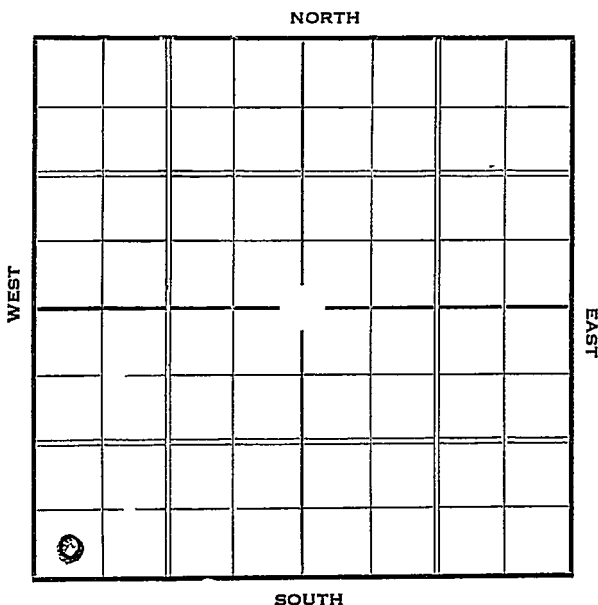

KANSAS

Russell

Map No. _____ Sec. 30 Twp. 14 R. 13-W

Well No. #8 Miller Farm _____

Smoky Hill Oil Company _____


_____ Ft. from N. Line

330 Ft. from S. Line

_____ Ft. from E. Line

330 Ft. from W. Line

Elev. 1717

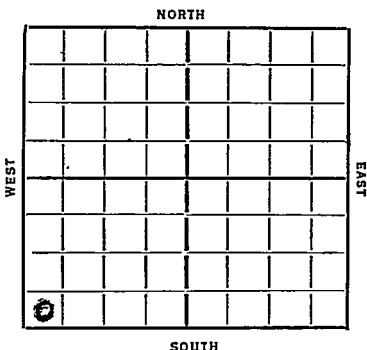

Date

REPORT

1936

12/22 Location

12/29 "

1937

1/7 15" @ 60'. 12" @ 360'.

10" @ 668'. Drlg. 1270'.

1/14 Drlg. 2020'.

1/21 8" @ 2350'. Drlg. 2820'.

1/28 Lansing 2848' Set 6".

2/4 Pay 2881-90 TD. 1700' oil in hole
800 acid No Test

2/10 Lansing 2848'.

T. D. 2900'.

8000 acid.

Potential 1296'.

COMPLETED

KANSAS

Map No. _____ Sec. 30 Twp. 14 R. 13W

Well No. 8 Miller

Smoky Hill Oil Company

Contractor _____

SECTION PLAT

_____ Ft. from N. Line

330 Ft. from S. Line

_____ Ft. from E. Line

330 Ft. from W. Line

(COMPLETED)

Location _____

Rig up _____

Drilling and Remarks:

*Leasing 2848
8000 acid
Potential
1296*

RECORD

Cased _____ in., _____ ft.

Sand _____

Gas _____

Oil _____

Total Depth 2900

PRODUCTION

1st 24 hrs. Nat. _____

1st 24 hrs. after shot _____

Gas _____ Cu. Ft.

Dry Hole _____

Abandoned _____

Date

FEB 10 1937

19

S. J. LEWIS Scout

Russell **KANSAS**

Map No. 72 Sec. 30 Twp. 14 R. 19W

Well No. J Miller

Smoky Hill Oil Company
 Contractor

SECTION PLAT

_____ Ft. from N. Line

330 Ft. from S. Line

_____ Ft. from E. Line

330 Ft. from W. Line

FIRST REPORT

Location ✓

Rig up _____

Drilling and Remarks:

RECORD

Cased _____ in., _____ ft.

Sand _____

Gas _____

Oil _____

Total Depth _____

PRODUCTION

1st 24 hrs. Nat. _____

1st 24 hrs. after shot _____

Gas _____ Cu. Ft.

Dry Hole _____

Abandoned _____

Date

DEC 22 1903 19

S. J. LEWIS Scout