

Sec. 28 Twp. 14 R. 13W

Well No. #5 Rogg Farm


R. H. Shields Company

330 Ft. from N. Line

 Ft. from S. Line

 Ft. from E. Line

990 Ft. from W. Line

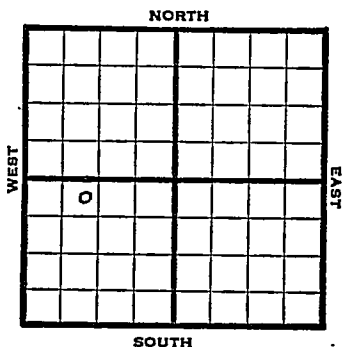

NE NW SW

1947

Elev. 1741 REPORT

9/24 Location

10/1 "

10/8 "

10/15 Rig

10/22 "

10/29 Drlg. 150'

11/5 160' lost tools skid rig
50' North

11/12 Drlg. 320'

11/19 10" @ 688'
Drlg. 1115'

11/25 Drlg. 1520'

12/3 8" @ 2280'
Topeka 2565'
Drlg. 2615'

12/10 Lansing 2880'
7" @ 2883'
TD 2925'
WOC

12/17 TD 2970'
100' oil 12 hrs.

OVER

1947

12/30 8000 acid.

1948

1/7 Lans. 2880'
7" @ 2885'
8000 Acid
Pump 290 Pot.
Gr. 40°
Total Depth 2970'
COMPLETED

Map No. _____ Sec. 28 Twp. 14 R. 13W

Well No. 5 Rogg

R. H. Shields Company

FIRST REPORT Contractor

NE NW SW

SECTION PLAT

330 Ft. from N. Line

_____ Ft. from S. Line

_____ Ft. from E. Line

990 Ft. from W. Line

Russell County

Location X

Rig up

Drilling and Remarks:

RECORD

Cased _____ in., _____ ft.

Sand _____

Gas _____

Oil _____

Total Depth _____

PRODUCTION

1st 24 hrs. Nat. _____

1st 24 hrs. after shot _____

Gas _____ Cu. Ft.

Dry Hole _____

Abandoned _____

Date

SEP 24 1947 19

S. J. LEWIS Scout

Map No. 72 Sec. 28 Twp. 14 R. 13W

Well No. 5 Rogg

R. H. Shields Company

COMPLETE Contractor

NE NW SW

E. 1741
SECTION PLAT

330 Ft. from N. Line

_____ Ft. from S. Line

_____ Ft. from E. Line

990 Ft. from W. Line

o			
i			

Russell County

Location _____

Rig up _____

Drilling and Remarks:

Lease 2880

7" C 2883

9000 acid

Aug 2900 ft

40 2/3 in.

RECORD

Cased _____ in., _____ ft.

Sand _____

Gas _____

Oil _____

Total Depth 2970

PRODUCTION

1st 24 hrs. Nat. _____

1st 24 hrs. after shot _____

Gas _____ Cu. Ft.

Dry Hole _____

Abandoned _____

Date

JAN 7 1948 19

S. J. LEWIS Scout