KANSAS


Form 51-5M 5-37 Petrol

Russell

Section 31 Township 14 Range 13-W

Well No. 13 - Guy Miller

Company Smokey Hill

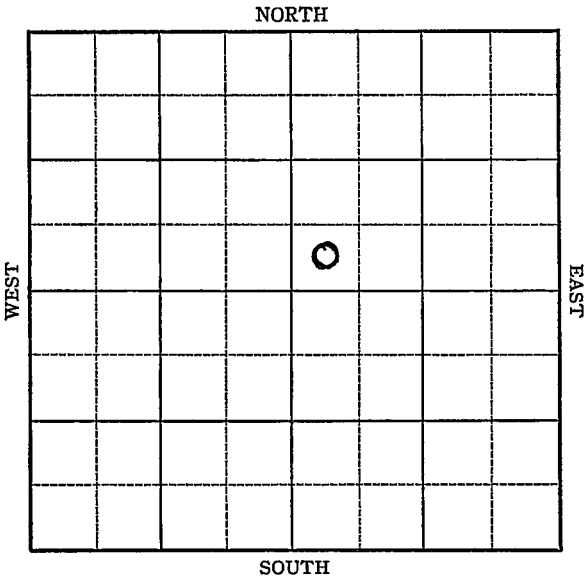


Form 252-A—5M—7-36—Palace **KANSAS** Russell

Sec. 31 Twp. 14 R. 13-W

Well No. #13 Guy Miller Farm

Smokey Hill Company

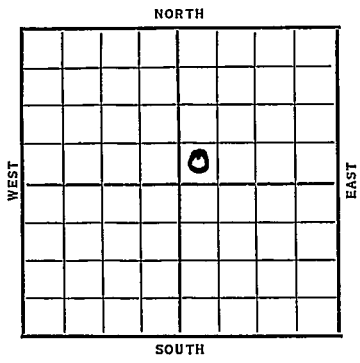

____ Ft. from N. Line

330 Ft. from S. Line

____ Ft. from E. Line

330 Ft. from W. Line

Elev. 1714

Date	REPORT
1937	
6/9	B. Cable Rig
6/19	Cable rig.
6/25	" "
7/2	" "
7/9	" "
7/16	" "
7/23	12" @ 355'. 10" @ 655'.
	Drlg. 665'.
7/30	Anhy 657'. Drlg. 1755'.
8/6	Drlg. 2260'.
8/13	8" @ 2278'. Oswald 2859'.
	7" @ 2859'. Drlg. 2862'.
8/20	T.D. 2934'. 8000 acid.
8/25	7" @ 2859'
	K.C. 2859'
	TD 2934'
	8000 acid
	Pot 1052
	COMPLETED

Form 26—1M Bks.—2-29 Russell KANSAS

Map No. 72 Sec. 31 Twp. 14 R. 13W

Well No. 13 - Guy Miller

Smokey Hill Company

Contractor

FIRST REPORT


Ft. from N. Line

330 Ft. from S. Line

Ft. from E. Line

330 Ft. from W. Line

SECTION PLAT

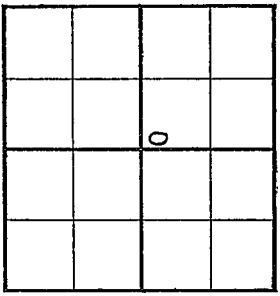

Location

Rig up

Drilling and Remarks:

B. Cable Rig

RECORD

Cased in ft.

Sand

Gas

Oil

Total Depth

PRODUCTION

1st 24 hrs. Nat.

1st 24 hrs. after shot

Gas Cu. Ft.

Dry Hole

Abandoned

Date

JUN 9 1937 19 H. D. Hatfield Scout

Form 26—1M/Brs—2-29 KANSAS Russell

Map No. Sec. 31 Twp. 14 R. 13W


Well No. 13 - Guy Miller

Smokey Hill Company

Contractor

COMPLETED

SECTION PLAT

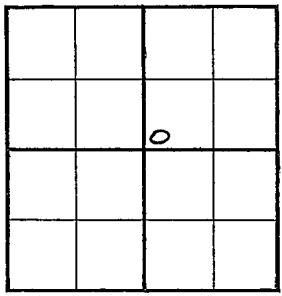

Ft. from N. Line

330 Ft. from S. Line

Ft. from E. Line

330 Ft. from W. Line

Location

Rig up

Drilling and Remarks:

8000 Acid

Pot - 1052

RECORD

Cased 7 in., 2859 ft.

~~Sand~~ KC 2859

Gas

Oil

Total Depth 2934

PRODUCTION

1st 24 hrs. Nat.

1st 24 hrs. after shot

Gas Cu. Ft.

Dry Hole

Abandoned

Date

AUG 25 1937 19

H. D. Hatfield Scout