

KANSAS

Form 51-5M-7-39-Palace


Russell

Section 28 Township 14- Range 13-W

Well No. #3 Rogg

Company R. H. Shields

NORTH Hall Pool

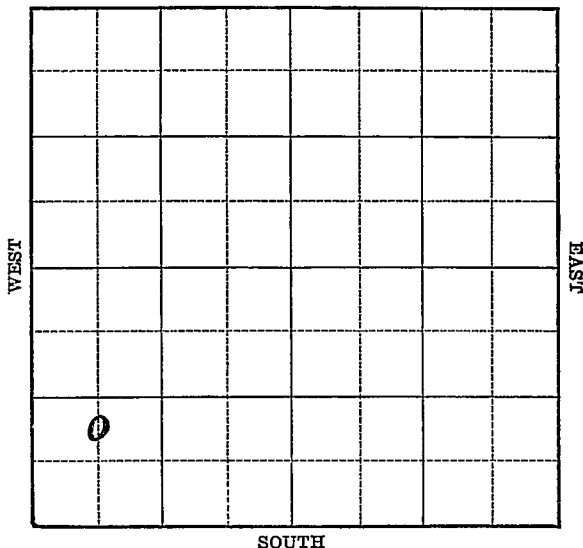

Sec. 28 Twp. 14 R. 13-W

Well No. #3 Rogg Farm

R. H. Shields Company

(Hall)


_____ Ft. from N. Line

990 Ft. from S. Line

_____ Ft. from E. Line

660 Ft. from W. Line

Elev. 1735

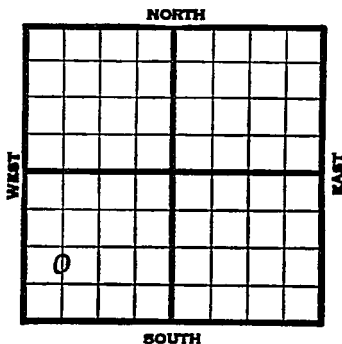

1939	REPORT
10/11	Bldg. cable rig.
10/19	Cable rig.
10/26	" " & Casing.
11/2	Spud.
11/9	20" - 30' 365' - 12½" cemented
	Drlg. 525'
11/16	Anhy 660' 10" - 670'
	Drlg. 1730'
11/23	Tarkio 2241' 8" - 2266'
	Drlg. 2395'
11/29	Drlg. 2840'
12/7	Lans. 2865' 7" - 2871'
	Oil 2903-11' T.D. 2918'
	400' oil 16 hours. Run tubing.
12/13	Lans. 2870'
	7" - 2870'
	T.D. 2918'
	5000 acid.
	Potential 595 bbls., pump.
	COMPLETED

Map No. 72 Sec. 28 Twp. 14 R. 13WWell No. 3 RoggR. H. Shields Company

Contractor

COMPLETED
C N L SW SW**SECTION PLAT**

 Ft. from N. Line990 Ft. from S. Line Ft. from E. Line660 Ft. from W. Line**HALL POOL.**Location Rig up Drilling and Remarks: *Lines 2870**7" C 2870**5000 acid**Pump 595 P.S.***RECORD**Cased in., ft.Sand Gas Oil Total Depth 2915**PRODUCTION**1st 24 hrs. Nat. 1st 24 hrs. after shot Gas Cu. Ft.Dry Hole Abandoned

Date

DEC 13 1939 19S I LEWIS Scout