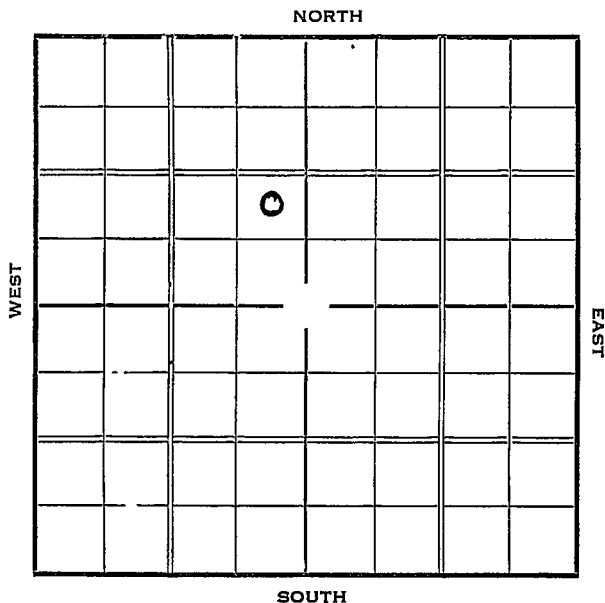



Russell

KANSAS

Section 31 Township 14 Range 13-WWell Number 4 L. MillerCompany Stearns & Streeter et al

Sec. 31 Twp. 14 R. 13-WWell No. #4 L. Miller Farm
Stearns & Streeter et al Company Ft. from N. Line990 Ft. from S. Line330 Ft. from E. Line Ft. from W. Line

Elev. 1710

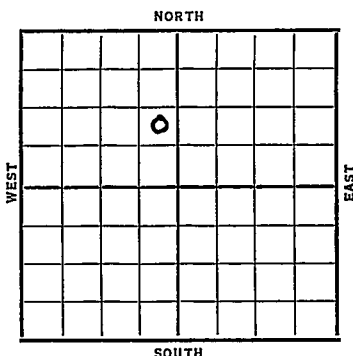

Date	REPORT
1937	
4/7	Location
4/16	Spud
4/23	15" @ 110'. 12" @ 348'.
	Anhydrate 650'.
	10" @ 650'. Drlg. 1045'.
4/30	Drlg. 1925'.
5/7	Show oil 2234-36'.
	8" @ 2295'. Drlg. 2435'.
5/14	Oswald 2839-40' T.D.
	6" @ 2835'. Drlg. plug.
5/21	T.D. 2936'. 5000 acid.
5/26	6" @ 2835'.
	Oswald 2839'.
	T.D. 2936'.
	5000 acid.
	Pot. 1151 bbls.
	COMPLETED

KANSAS Russell

Map No. _____ Sec. 31 Twp. 14 R. 13WWell No. 4 L. MillerStearns & Streeter & Co. Company

Contractor

SECTION PLAT

_____ Ft. from N. Line

990 Ft. from S. Line380 Ft. from E. Line

_____ Ft. from W. Line

FIRST REPORT

Location ✓

Rig up _____

Drilling and Remarks:

RECORD

Cased _____ in., _____ ft.

Sand _____

Gas _____

Oil _____

Total Depth _____

PRODUCTION

1st 24 hrs. Nat. _____

1st 24 hrs. after shot _____

Gas _____ Cu. Ft.

Dry Hole _____

Abandoned _____

Date

APR 7 1937 19

S. J. LEWIS Scout

Russell KANSAS

Map No. _____ Sec. 31 Twp. 14 R. 13^WWell No. 4-L MillerStearns & Streeter Company

Contractor

COMPLETED

SECTION PLAT

	0		

_____ Ft. from N. Line

990 Ft. from S. Line330 Ft. from E. Line

_____ Ft. from W. Line

Location _____

Rig up _____

Drilling and Remarks:

5000 Acid.Rot - 1151

RECORD

Cased 6 in., 2835 ft.~~Sand~~ Oswald 2839

Gas _____

Oil _____

Total Depth 2936

PRODUCTION

1st 24 hrs. Nat. _____

1st 24 hrs. after shot _____

Gas _____ Cu. Ft.

Dry Hole _____

Abandoned _____

Date

MAY 26 1937

19

H. D. Hatfield

Scout