


Section 29 Township 14 Range 13-W

Well No. 1 Carter

Company Cities Service Oil

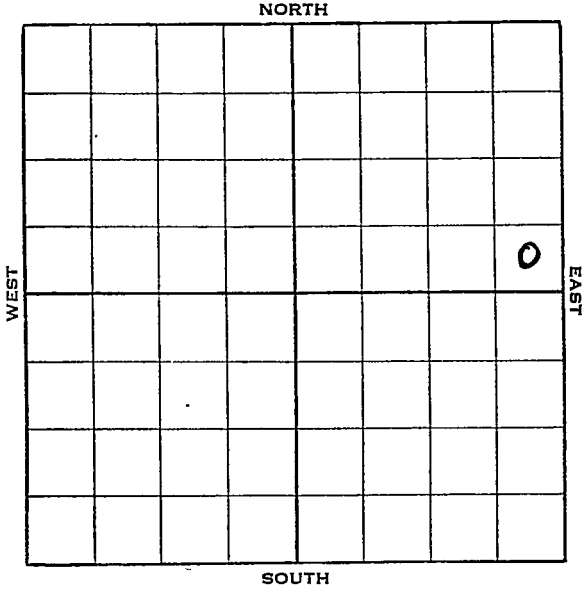

Map No. 72 Sec. 29 Twp. 14 R. 13W

Well No. 1 Carter

Cities Service Oil Company

Contractor

FIRST REPORT

SECTION PLAT

SE NE

_____ Ft. from N. Line

330 Ft. from S. Line

330 Ft. from E. Line

_____ Ft. from W. Line

			0

Location X

Rig up _____

Drilling and Remarks:

RECORD

Cased _____ in., _____ ft.

Sand _____

Gas _____

Oil _____

Total Depth _____

PRODUCTION

1st 24 hrs. Nat. _____

1st 24 hrs. after shot _____

Gas _____ Cu. Ft.

Dry Hole _____

Abandoned _____

Date

APR 6 - 1938 19

H. D. Hatfield Scout

Russell KANSAS

Map No. 72 Sec. 29 Twp. 14 R. 13WWell No. 1 CarterCities Service Oil

Company

Contractor

COMPLETED

SE NE

Ft. from N. Line

330 Ft. from S. Line330 Ft. from E. Line

Ft. from W. Line

SECTION PLAT

			0

Location _____

Rig up _____

Drilling and Remarks:

8000 AcidPOT 1321

RECORD

Cased 7 in., 2914 ft.Sand K.C., 2883

Gas _____

Oil _____

Total Depth 2927

PRODUCTION

1st 24 hrs. Nat. _____

1st 24 hrs. after shot _____

Gas _____ Cu. Ft.

Dry Hole _____

Abandoned _____

Date

MAY 25 1938 19

H. D. Hatfield Scout