Form 51-5M 5-37 Petrol


KANSAS

Russell

Section 31 Township 14 Range 13-W

Well No. 4 L. Miller

Company J. J. Hall

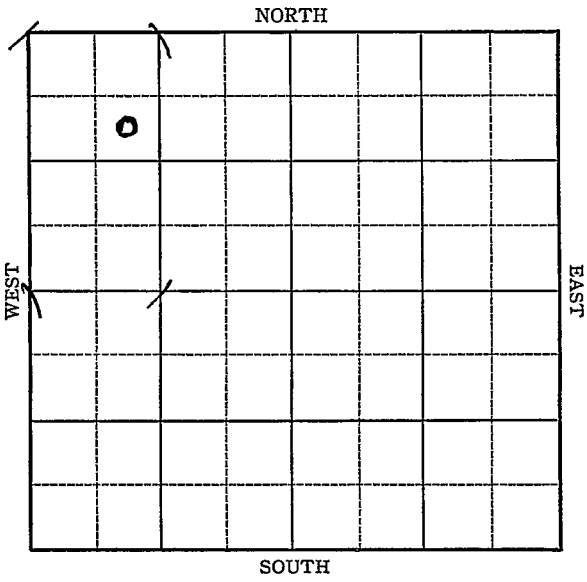

Form 252-A—5M—9-37 KANSAS Russell

Sec. 31 Twp. 14 R. 13-W

Well No. #4 L. Miller Farm

J. J. Hall Company


990 Ft. from N. Line

Ft. from S. Line

Ft. from E. Line

990 Ft. from W. Line

Elev. 1711

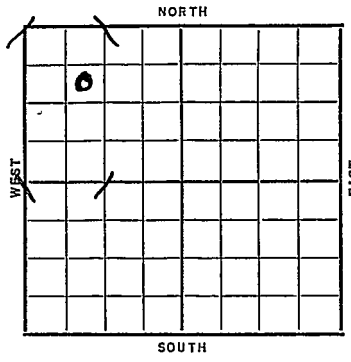

Date	REPORT
1937	
12/1	B.C.R.
12/10	Rig.
12/17	"
12/24	"
12/31	"
1938	
1/7	15" @ 20'. 12" @ 343'.
	SD Rep. @ 415'.
1/14	Anhy 653'. 10" @ 659'.
	Drlg. 1385'.
1/20	T.D. 2270' Rng. 8"
1/28	S.O. 2225' 8" - 2270'
	6"- 2855' Co.
2/5	1200' Oil 2915-23'
	T.D. 3040' C.O.
2/11	S.O. 3033-40'. 5" @ 3080'.
	Cong. 3109'. Gorham 3114-3120
	T.D. 3120'. Pay 3114-20'.
	2500' oil 2 hrs.
2/18	T.D. 3122'. Testing.

OVER

1938

2/23 5" @ 3080'.

Gorham 3114'.

T.D. 3122'.

Potential 1872'.

COMPLETED

Form 26—1M Bks.—2-29

Russell KANSAS

Map No. 72 Sec. 31 Twp. 14 R. 13W

Well No. 4 L. Miller

J. J. Hall Company

Contractor

FIRST REPORT

SE NW NW


990 Ft. from N. Line

Ft. from S. Line

Ft. from E. Line

990 Ft. from W. Line

SECTION PLAT

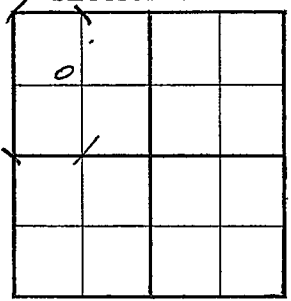

Location

Rig up

Drilling and Remarks:
BCR

RECORD

Cased in., ft.

Sand

Gas

Oil

Total Depth

PRODUCTION

1st 24 hrs. Nat.

1st 24 hrs. after shot

Gas Cu. Ft.

Dry Hole

Abandoned

Date

DEC 1- 1937 19 H. D. Hatfield Scout

Form 26—1M Bks.—2-29

Russell KANSAS

Map No. 72 Sec. 31 Twp. 14 R. 13W

Well No. 4 L. Miller

J. J. Hall Company

Contractor

COMPLETED

SE NW NW


990 Ft. from N. Line

Ft. from S. Line

Ft. from E. Line

990 Ft. from W. Line

SECTION PLAT

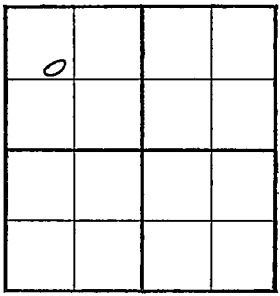

Location

Rig up

Drilling and Remarks:

POT 1872

RECORD

Cased 5 in., 3080 ft.

Sand Gorham 3114

Gas

Oil

Total Depth 3122

PRODUCTION

1st 24 hrs. Nat.

1st 24 hrs. after shot

Gas Cu. Ft.

Dry Hole

Abandoned

Date

FEB 23 1938 19 H. D. Hatfield Scout