

Barton

FORM 51 25M 3-49 PETROL

KANSAS

Section 20 Township 16 Range 13W

Well No. #1 Stoskopf

Company Wm. Graham Oil

NORTH

○									

SOUTH

WEST

EAST

Sec. 20 Twp. 16 R. 13W

Well No. #1 Stoskopf Farm

Wm. Graham Oil Company

Contractor

**Trapp Pool**


\_\_\_\_\_ Ft. from N. Line

330' Ft. from S. Line

\_\_\_\_\_ Ft. from E. Line

330' Ft. from W. Line

SW SW NW

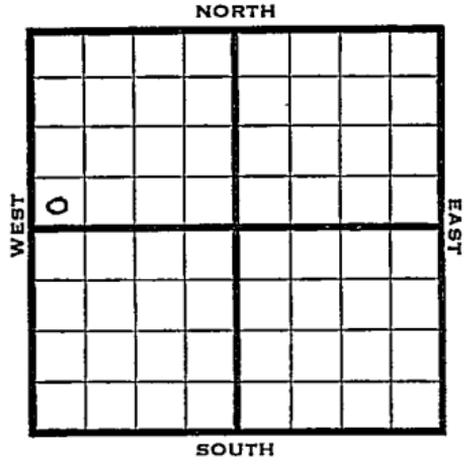

1950 Elev 1958 **REPORT**

4/19

Location

6/14

8" @ 156  
 Anhy 910-40  
 Ft. Riley 1705  
 Lans. 3153  
 DST 3241-56, opn 40 min, rec 30' mud  
 Arb 3391-96  
 5½" @ 3392  
 TD 3412  
 Comp 49 bopd  
 Completed

**COMPLETED**

Kansas

Trapp Pool

Map No. \_\_\_\_\_ Sec. 20 Twp. 16 R. 13W

Well No. 1 Stoskopf

Wm. Graham Oil \_\_\_\_\_ Company

\_\_\_\_\_  
Contractor

SE SW NW


## SECTION PLAT

\_\_\_\_\_ Ft. from N. Line

330 Ft. from S. Line

\_\_\_\_\_ Ft. from E. Line

330 Ft. from W. Line

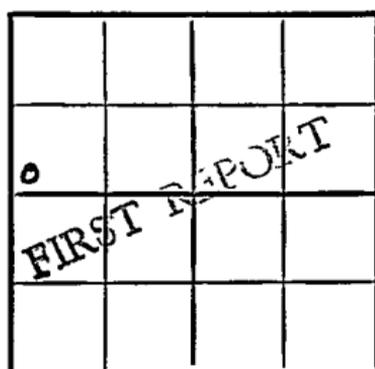

Barton County

Continental farmou

Location X

Rig up \_\_\_\_\_

Drilling and Remarks:

## RECORD

Cased \_\_\_\_\_ in., \_\_\_\_\_ ft.

Sand \_\_\_\_\_

Gas \_\_\_\_\_

Oil \_\_\_\_\_

Total Depth \_\_\_\_\_

## PRODUCTION

1st 24 hrs. Nat. \_\_\_\_\_

1st 24 hrs. after shot \_\_\_\_\_

Gas \_\_\_\_\_ Cu. Ft.

Dry Hole \_\_\_\_\_

Abandoned \_\_\_\_\_

Date

APR 19 1950 19

J. E. TYRA Scout

Map No. \_\_\_\_\_ Sec. 20 Twp. 16 R. 13WWell No. 1 Stoskopf

\_\_\_\_\_ Wm. Graham Oil \_\_\_\_\_ Company

\_\_\_\_\_ Contractor


SW SW NW

El. 1958  
SECTION PLAT

\_\_\_\_\_ Ft. from N. Line

330 Ft. from S. Line

\_\_\_\_\_ Ft. from E. Line

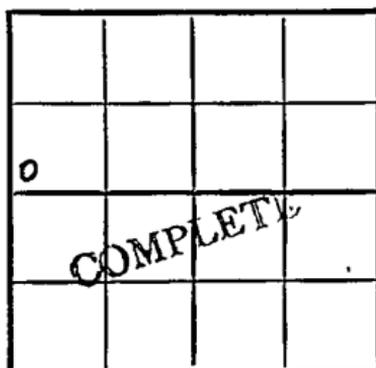330 Ft. from W. Line

Barton County

Location \_\_\_\_\_

Rig up \_\_\_\_\_

Drilling and Remarks:

8" @ 156

Anhy 910-40

Ft. Riley 1705

Lans. 3153

DST 3241-56

open 40 min.

Rec. 30' mud

## RECORD

Cased \_\_\_\_\_ in., \_\_\_\_\_ ft.

Sand \_\_\_\_\_

Gas \_\_\_\_\_

Oil \_\_\_\_\_

Total Depth 3412

## PRODUCTION

1st 24 hrs. Nat. \_\_\_\_\_

1st 24 hrs. after shot \_\_\_\_\_

Gas \_\_\_\_\_ Cu. Ft.

Dry Hole \_\_\_\_\_

Abandoned \_\_\_\_\_

Date

JUN 14 1950 19J. E. TYRA Scout

Arb. 3391-96

5 1/2" © 3392

TD 341-2

comp. 49 popd

JUN 19 1950

.....	Misc.
.....	Pierce Map
.....	France Map
.....	Tracings
.....	Land Wall Map
.....	Land Small Map
.....	Scout Cards

7 (M)

MECOS


ECIC