

KANSAS

Russell

Section 28 Township 14 Range 13W

Well No. 1 Sherwood

Company W.H. Black
Hall-Gurney

NORTH

WEST

EAST

0							

SOUTH

Russell

KANSAS

Sec. 28 Twp. 14 R. 13W

Well No. #1 Sherwood Farm _____

W. H. Black Company

Hall-Gurney Pool (Black, Cont.)


NORTH

990' Ft. from N. Line

_____ Ft. from S. Line

_____ Ft. from E. Line

330' Ft. from W. Line

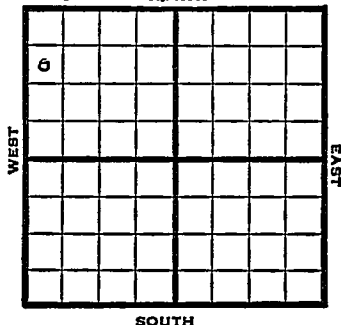

SW NW NW

SOUTH

1949 Elev 1749' REPORT

6/22 8" @ 405'
Anhy 705'
Drlg. 1780'

6/28 Lansing 2886'
Gorham 3165-69'
TD 3169'
5" @ 3165'

7/6 "

7/12 Plug 2950'
24 shots 2922-29'
12 shots 2895-97'
1000 acid
Swb 3 bbls oil PH

7/20 "

7/27 "

8/3 "

8/10 "

8/17 "

8/24 TD 3169' -
Gorham 3165'
Aband.

ABANDONED

Map No. _____ Sec. 28 Twp. 14 R. 13W

Well No. 1 Sherwood

W. H. Black Company

Black Contractor

SW NW NW


FIRST REPORT
SECTION PLAT

990 Ft. from N. Line

_____ Ft. from S. Line

_____ Ft. from E. Line

330 Ft. from W. Line

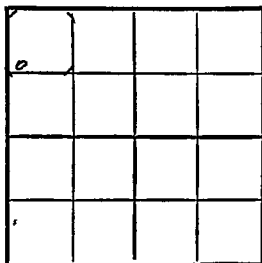

Russell County

RECORD

Location _____

Cased _____ in., _____ ft.

Rig up _____

Sand _____

Drilling and Remarks:

Gas _____

8" @ 405

Oil _____

Anhy 705

Total Depth _____

drlg. 1780

PRODUCTION

1st 24 hrs. Nat. _____

1st 24 hrs. after shot _____

Gas _____ Cu. Ft.

Dry Hole _____

Abandoned _____

Date

JUN 22 1949

S. J. LEWIS

Scout

Map No. K 72 Sec. 28 Twp. 14 R. 13W

Well No. 1 Sherwood

W. H. Black Company

ABANDONED

Contractor

SW NW NW

E 11749
SECTION PLAT

990 Ft. from N. Line

0			

_____ Ft. from S. Line

_____ Ft. from E. Line

330 Ft. from W. Line

Russell County

Location _____

Rig up _____

Drilling and Remarks:

See log 3/65

RECORD

Cased _____ in., _____ ft.

Sand _____

Gas _____

Oil _____

Total Depth 3169

PRODUCTION

1st 24 hrs. Nat. _____

1st 24 hrs. after shot _____

Gas _____ Cu. Ft.

Dry Hole _____

Abandoned _____

Date

AUG 24 1949 19

S. J. LEWIS Scout