


Section 29 Township 14 Range 13 W

Well No. # 1 Carter

Company Clyde Kissinger

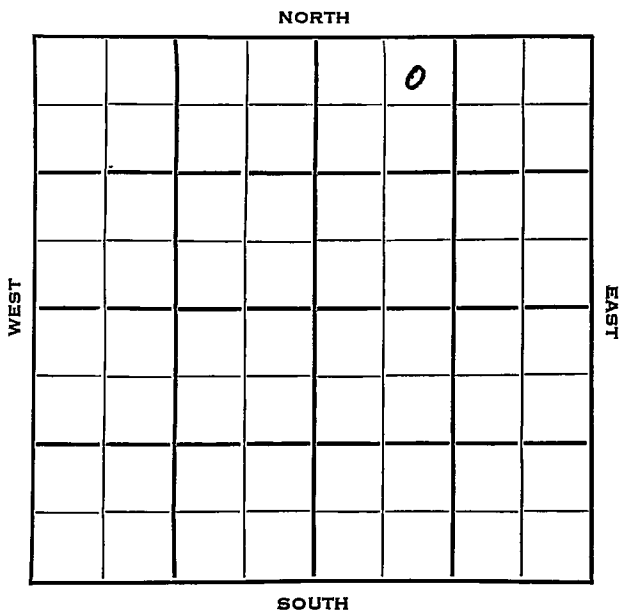

Sec. 29 Twp. 14 R. 13W

Well No. #1 Carter Farm \_\_\_\_\_

Clyde Kissinger Company \_\_\_\_\_

Duke & Wood Contractor \_\_\_\_\_

Hall-Gurney Pool


330 Ft. from N. Line

\_\_\_\_\_ Ft. from S. Line

\_\_\_\_\_ Ft. from E. Line

990 Ft. from W. Line

NE NW NE

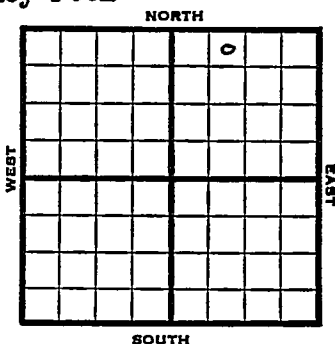

1953 Elev. 1765' REPORT

6/3 Loc.

6/10 8" @ 190'

6/24 Tarkio 2269 RTD 2330 5" @ 2329

7/1 20/2292-94  
Sd-frac, lost load, PB  
30/2272-75

7/8 Spud 6-8-53  
Oil Well  
TD 2330'  
8" @ 190'  
Tarkio 2269  
TD 2330'  
5" @ 2329'  
20/ 2292-94 sd-frac PB 2280  
30/ 2272-75 sd-frac S. 6½ boph  
Comp. 25 bopd.

**COMPLETED**



