

KANSAS

Form 51-5M-7-39-Palace

Russell

O. W. P. B.


Section 29 Township 14 Range 13-W

Well No. #3 Quarter

Company Cities Service Oil

NORTH

Hall Pool

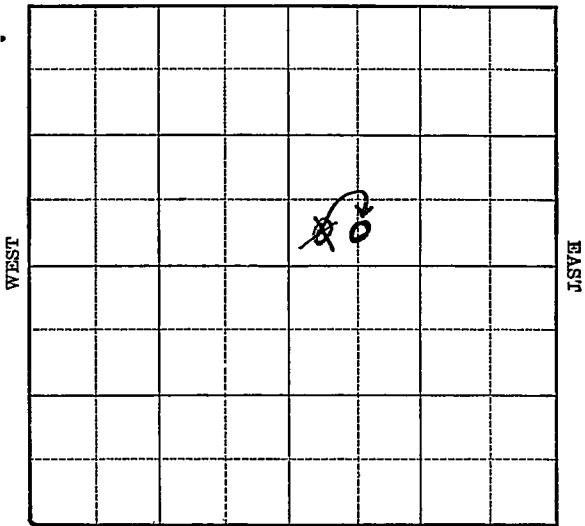

SOUTH



O. W. P. B.

Sec. 29 Twp. 14 R. 13-W

Well No. #3 Carter Farm

Cities-Service Oil Company

(Hall)


 Ft. from N. Line

330 Ft. from S. Line

 Ft. from E. Line

660
440 Ft. from W. Line

C S/2 SW NE
Elev. 1757

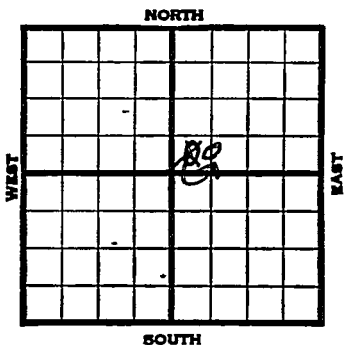

1939	REPORT
10/4	Location
10/14	12" - 307' WOC.
10/19	Drlg. 2600'
10/26	Lans. 2891' 8" - 2912'
	S.O. 2916-21' RUST.
11/2	T.D. 2993' 5000 acid.
	Pump 16 oil, 4% B.S. 6 hours.
	5000 acid. Testing.
11/18	
11/8	Lans. 2891'
	8" - 2912'
	T.D. 2993'
	10,000 acid.
	Potential 863 bbls., pump.

COMPLETED

1952 **O. W. P. B.**

7/16 Lans. 2891' -Prod. 8" @ 2912'
 OTD 2993' PB 2305' 12/2293-2304
 12/2268-78, 6/2303-05, 6/2286-88
 6/2262-64 sq. C02307'. 11/2296-2303'
 24/2295-2304 7/2301-04 7/2293-96
 5/2293-95 5/2298-2302 24/2271-80

OVER

1952

7/16

(Information continued)

23/2271-80 14/2268-71' Sand frac.

CO 2339' P/3 BO plus 9 BW 4 hrs.

7/23

NR

7/30

Oil well TD 2993' Lans. 2891'

8" @ 2912' OTD 2993' PB 2906'

12/2293-2304 12/2268-78 6/2303-05

6/2286-88 6/2262-64 CO to 2307

14/2296-2303 24/2295-2304 7/2301-04

7/2293-96 5/2293-95 5/2298-2302

24/2271-80 23/2271-80 14/2268-71

sd-frac. CO to 2339

Comp. 3 BOPD 9 BW

COMPLETED

County Russell State Kansas

Sec. 29 (Blk. Twp.) 14 (Sur. Rge.) 13W Map No.

Operator Cities Service Oil

Well No. 3 Farm Carter

Elev. 1757 Location C S/2 SW NE

330 Ft. From S Line NE

660 Ft. From W Line Quarter

1st. Report JUL 16 1952

Completion _____

Remarks _____

Spudding Date _____

Drlg. Data

Lans 2891-prod. 8" @ 2912 OTD 2993
PB 2306 12/2293-2304 12/2268-78 6/2303-05
6/2286-88 6/2262-64 sq CO 2307 14/2296-2303
24/2295-2304 7/2301-04 7/2293-96 5/2293-96
5/2295-2302 24/2271-80 23/2271-80 14/2268-
71 sd-frac CO 2339 P/3 Bo plus 9 BW 4hrs.

J. G. McGEHEE

County Russell State Kansas
 Sec. 29 (Blk. 14) (Sur. 13W) (Twp. 14) (Rge. 13W) Map No.
 Operator Cities Service Oil
 Well No. 3 Farm Carter
 Elev. 1757 Location C S L SW NE

COMPLETE

330 Ft. From S Line NE
660 Ft. From W Line Quarter
 Ist. Report
 Completion JUL 30 1952
 Remarks

Drilg. Data Oil well TD 2993
Lans. 2891 8" @ 2912 OTD 2993
PB 2306 12/ 2293-2304 12/ 2268-78
6/ 2303-05 6/ 2286-88 6/ 2262-64
CO to 2307 14/ 2296-2303 24/ 2295-2304
7/ 2301-04 7/ 2293-96 5/ 2293-95
5/ 2298-2302 24/ 2271-80 23/ 2271-80
14/ 2268-71 sd-frac CO to 2339
Comp. 3 bopd 9 bw

Map No. _____ Sec. 29 Twp. 14 R. 13WWell No. 3 CarterCities Service Oil

Company

Contractor

FIRST REPORT

C S L SW NE

SECTION PLAT

_____ Ft. from N. Line

330 Ft. from S. Line

_____ Ft. from E. Line

440 Ft. from W. Line

HALL POOL

Location X

Rig up _____

Drilling and Remarks:

RECORD

Cased _____ in., _____ ft.

Sand _____

Gas _____

Oil _____

Total Depth _____

PRODUCTION

1st 24 hrs. Nat. _____

1st 24-hrs. after shot _____

Gas _____ Cu. Ft.

Dry Hole _____

Abandoned _____

Date

OCT 4 1939₁₉S. J. LEWIS

Scout

Map No. _____ Sec. 29 Twp. 14 R. 13W

Well No. 3 Carter

Cities Service Oil Company

Contractor

COMPLETED

C S L SW NE

SECTION PLAT

_____ Ft. from N. Line

330 Ft. from S. Line

_____ Ft. from E. Line

660 Ft. from W. Line

HALL POOL

Location _____

Rig up _____

Drilling and Remarks:

Lans. 2891
8" C 2912.
10000 acid
Pump 563 P.X.

RECORD

Cased _____ in., _____ ft.

Sand _____

Gas _____

Oil _____

Total Depth 2993

PRODUCTION

1st 24 hrs. Nat. _____

1st 24 hrs. after shot _____

Gas _____ Cu. Ft.

Dry Hole _____

Abandoned _____

Date

Nov 1939 19

S I LEWIS Scout

First report shows this well as
330' from south line and 440' from
west line in SW SW NE.

Check and advise.

Paul.

Misc Small Maps	<i>RAY</i>
Cards	<i>Paul</i>
11 x 18	<i>OK</i>
	<i>X</i>
	<i>RAY</i>
	<i>X</i>

No. 72 Sec. 29 Twp. 14 R. 13W

Well No. 3 Carter

Cities Service Oil Company

CORRECTION Contractor

SECTION PLAT

C S I SW NE

Ft. from N. Line

330 Ft. from S. Line

Ft. from E. Line

660 Ft. from W. Line

Hall Pool

Location

Rig up

Drilling and Remarks:

Reported:

330 x 440

RECORD

Cased in., ft.

Sand

Gas

Oil

Total Depth

PRODUCTION

1st 24 hrs. Nat.

1st 24 hrs. after shot

Gas Cu. Ft.

Dry Hole

Abandoned

Date

NOV 14 1939 19

S. J. LEWIS

Scout