

Russell.


KANSAS

Form 51-5M-11-38-Palace

Section 29 Township 14 Range 13-W

Well No. 2 Carter

Company Cities Service Oil

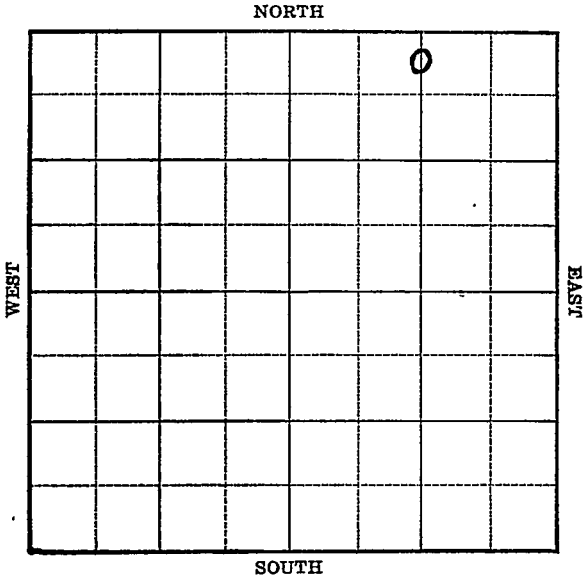

KANSAS

Russell

Sec. 29 Twp. 14 R. 13-W

Well No. #2 Carter Farm

Cities Service Oil Company


330 Ft. from N. Line

_____ Ft. from S. Line

_____ Ft. from E. Line

1320 Ft. from W. Line

Elev. 1765

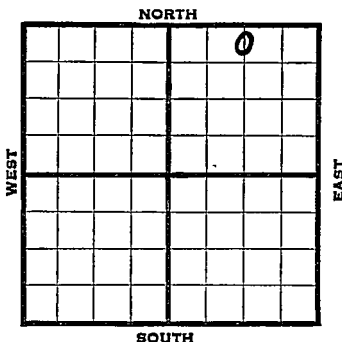

1938	REPORT
11/30	Location
12/9	R U R.
12/15	12" - 317'. Drlg. 480'.
12/23	Drlg. 2460'.
12/30	Lans. 2903'. T. D. 2911' S. O. 7" - 2905'. RUST.
1939	
1/6	Pay 2985-92'. T. D. 2998'. 300' oil in 14 hrs. Will treat.
1/11	7" - 2905'. Lans. 2903'. T. D. 2998'. 8000 acid. Pump 327 bbls. 8 hrs. Potential 981 bbls. Plus 3% water.
COMPLETED	

Map No. 72 Sec. 29 Twp. 14 R. 13WWell No. 2 CarterCities Service Oil Company

Contractor

FIRST REPORT

C N L NE

330 Ft. from N. Line

_____ Ft. from S. Line

1320 Ft. from E. Line

_____ Ft. from W. Line

SECTION PLAT

			0

Location X

Rig up _____

Drilling and Remarks:

RECORD

Cased _____ in., _____ ft.

Sand _____

Gas _____

Oil _____

Total Depth _____

PRODUCTION

1st 24 hrs. Nat. _____

1st 24 hrs. after shot _____

Gas _____ Cu. Ft.

Dry Hole _____

Abandoned _____

Date

NOV 30 1938 19H. D. Hatfield Scout

Russell **KANSAS**Map No. _____ Sec. 29 Twp. 14 R. 13WWell No. 2 CarterCities Service Oil

Company

Contractor

COMPLETED**C N L NE**330 Ft. from N. Line

_____ Ft. from S. Line

1320 Ft. from E. Line

_____ Ft. from W. Line

SECTION PLAT

			0

HALL LANSING, POOL

Location _____

Rig up _____

Drilling and Remarks:

*8000 acid**P-3278**POT 981**Plus 3 90 wtr***RECORD**Cased 7 in., 2905 ft.Sand LANS 2903

Gas _____

Oil _____

Total Depth 2998**PRODUCTION**1st 24 hrs. Nat. ✓

1st 24 hrs. after shot _____

Gas _____ Cu. Ft.

Dry Hole _____

Abandoned _____

Date

JAN 11 1938₁₉H. D. Hatfield Scout