

Russell

FORM 51

KANSAS

Section 29 Township 14 Range 13W

Well No. #2 Carter

Company United Drlg.

NORTH

						0	

WEST

EAST

SOUTH

Russell

KANSAS

SEC	TWP.	R.
29-	14	13 W

WELL NO.

# 2 Carter

FARM

COMPANY

United Drlg.

CONTRACTOR

Hall-Burney Pool

330

Ft. from N. Line


Ft. from S. Line

990

Ft. from E. Line

Ft. from W. Line

NW NE NE

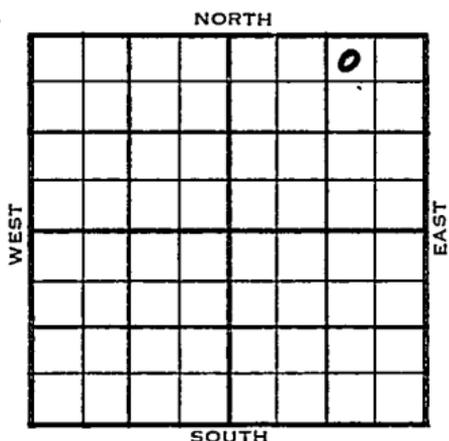

1953

ELEVATION

1761'

REPORT

9/23

Cellar &amp; Pits

10/7

8" @ 181 Anhy 715'  
Drlg. 2291'

10/14

Tarkio 2291'  
RTD 2333'  
5" @ 2333'  
CO 2308'  
8/2269-71, 8/2289-91

10/21

Sd-frac  
Spud 9-30-53  
Oil Well  
TD 2333'  
8" @ 181  
Anhy 715, Tarkio 2291  
TD 2333'  
5" @ 2333  
CO to 2308  
8/2269-71, 8/2289-91  
sd-frac  
S/7½ boph  
Comp. 50 bopd**COMPLETED**



