

# KANSAS

Russell

Form 51-5M-7-40-Palace


Section 29 Township 14 Range 13-W

Well No. #4 Carter

Company Cities Service Oil

NORTH

Hall Pool

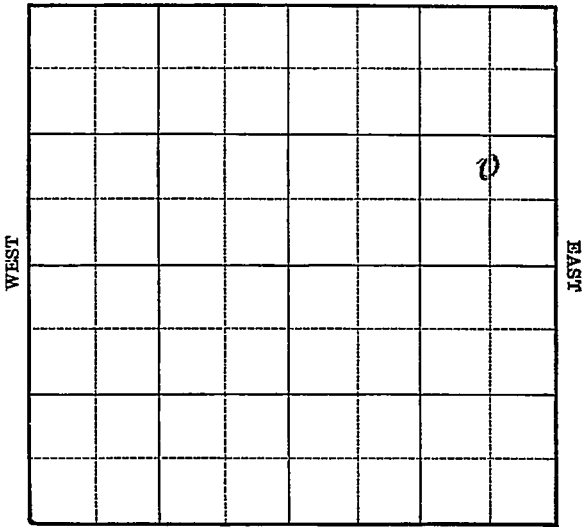

SOUTH

Sec. 29 Twp. 14 R. 13 -W

Well No. #4 Carter Farm \_\_\_\_\_

Cities Service Oil Company \_\_\_\_\_

(Hall)


\_\_\_\_\_ Ft. from N. Line

990 Ft. from S. Line

660 Ft. from E. Line

\_\_\_\_\_ Ft. from W. Line

Elev. 1754

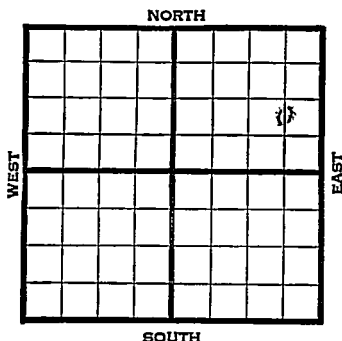

1940	REPORT
10/23	8" - 300'
	Drlg. 500'
10/31	Lans. 2889' SO 2906-098, 2924-35
	2983-3004 & 3083-92'
	Drlg. 3106'
11/7	Gorham 3167-68' T.D. 5" - 3168'
	117 shots 2904-2993' 1600' oil.
	8000 acid.
11/13	Gorham 3167'
	5" - 3168'
	T.D. 3168'
	117 shots 2904-2983'
	Lans. 2889'
	8000 acid.
	Depthograph potential 1438 bbls.
	COMPLETED



