


O W P. R.

Section 29 Township 14 Range 13-WF

Well No. #1 Opdycke

Company Braden & McClure

Hall Gurney Pool

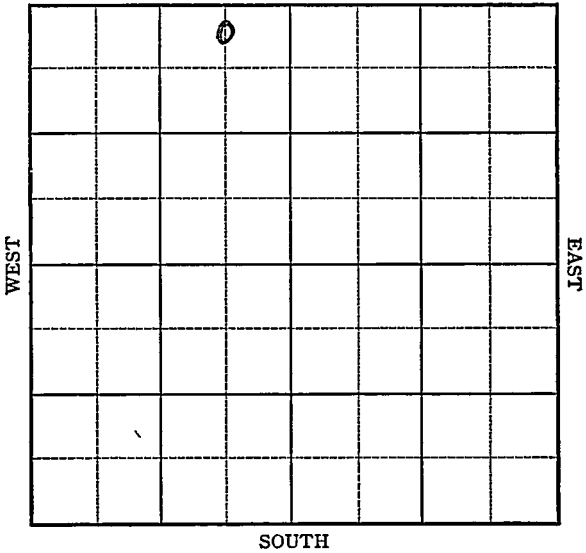

Sec. 29 - Twp. 14 R. 13-W

Well No. #1 Opdycke Farm
Braden & McClure Company

(Hall-Gurney) **O. W. P. B.** NORTH


330 Ft. from N. Line

_____ Ft. from S. Line

660 Ft. from E. Line

_____ Ft. from W. Line

Elev. 1766

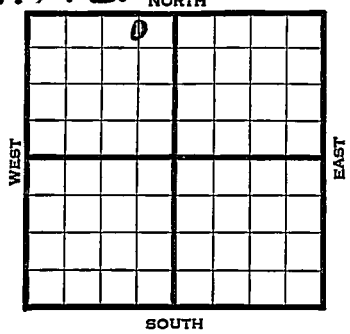

1941	REPORT
10/15	Cable.
10/23	"
10/30	"
11/6	Rigging up.
11/13	16" - 59' 12" - 390'
	Anhy 698' 10" - 712'
	Drlg. 835'
11/20	Drlg. 1720'
11/26	Tarkio 2280' 8" - 2330'
	Drlg. 2530'
12/4	Tepoka 2610' Lans. 2899'
	T.D. 2905' Run csg.
12/11	7" @ 2921 SS 62925-30
	Td 2942 CO

OVER

1941
12/17 Lans 2899
 7" @ 2921
 8000 acid
 Pump 364 Potential
 TD 2942
 Grav. 39

COMPLETED

1951

O. W. P. B.

4/25 Tarkio 2335 OTD 2942
 7" @ 2921 SP 2500
 To test Tarkio

6/13 Oil well TD 2360'
 Tarkio 2335' OTD 2942' 7" @ 2921
 SP 2500 CO to 2360 10/2281-86
 Hydrofrac 20/2332-36. Hydrofrac
 2000 A
 Comp. 35 BOPD

COMPLETED

Map No. H-72 Sec. 29 Twp. 14 R. 13WWell No. 1 OndyckeBraden & McClure CompanyFIRST REPORT Contractor

C NL NE NW

SECTION PLAT

330 Ft. from N. Line

_____ Ft. from S. Line

660 Ft. from E. Line

_____ Ft. from W. Line

HALL GURNEY POOL

	0		

Location _____

Rig up _____

Drilling and Remarks:

Cable _____

RECORD

Cased _____ in., _____ ft.

Sand _____

Gas _____

Oil _____

Total Depth _____

PRODUCTION

1st 24 hrs. Nat. _____

1st 24 hrs. after shot _____

Gas _____ Cu. Ft.

Dry Hole _____

Abandoned _____

Date

OCT 15 1941 19S. J. LEWIS

Scout

Russell

KANSAS

Map No. 72 Sec. 29 Twp. 14 R. 13W

Well No. 1 Opdycke

Braden & McClure Company

COMPLETED Contractor

C NL NE NW

330 Ft. from N. Line

_____ Ft. from S. Line

660 Ft. from E. Line

_____ Ft. from W. Line

SECTION PLAT

	0		

HALL GURNEY POOL

Location _____

Rig up _____

Drilling and Remarks:

None 2999
7" @ 2991
8000 and
Pump 3640 ft.

390 gr

RECORD

Cased _____ in., _____ ft.

Sand _____

Gas _____

Oil _____

Total Depth 2942

PRODUCTION

1st 24 hrs. Nat. _____

1st 24 hrs. after shot _____

Gas _____ Cu. Ft.

Dry Hole \$ _____

Abandoned _____

Date

DEC 17 1941 19

S. J. LEWIS Scout

County **Russell** State **Kansas**

Sec. **29** (Blk. Twp.) **14** (Sur. Rge.) **13W** Map No.

Operator **Braden Oil**

Well No. **1** Farm **Opdyoke**

Elev. Location **E N L NE NW**

		0			

330Ft. From **N** Line **NW**
660Ft. From **E** Line **Quarter**

1st. Report **APR 25 1951**

Completion

FIRST REPORT

Remarks **OWPB**

Spudding Date

Drlg. Data

Tarkio 2335 OTD 2942 7" @ 2921

SP 2500 to test Tarkio

