


Section 29 Township 14 Range 13W

Well No. #3 Opdycke

Company John Braden

Hall-Gurney NORTH

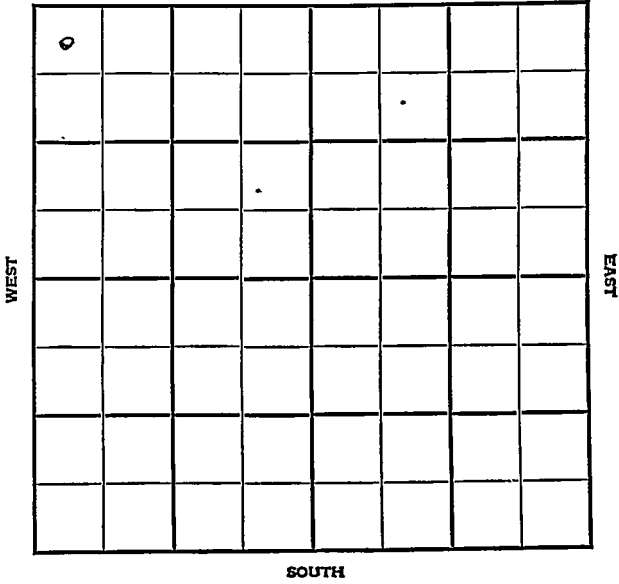

Sec. 29 Twp. 14 R. 13W

Well No. #3 Opdycke Farm  
John Braden Company

Hall-Gurney Pool


330' Ft. from N. Line

\_\_\_\_\_ Ft. from S. Line

\_\_\_\_\_ Ft. from E. Line

330' Ft. from W. Line

NW/C

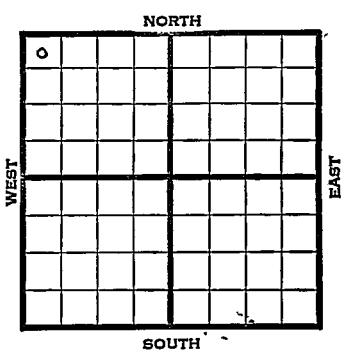

1948

Elev 1764' REPORT

- 3/24 Surface Hole
- 3/31 "
- 4/7 Lansing 2902'  
Granite 3216'  
TD 3217'  
5" @ 2994'
- 23 shots 2928-37' - 6000 acid.
- 4/14 "
- 4/21 "
- 4/28 "
- 5/5 "
- 5/12 "
- 5/19 "
- 5/26 "
- 6/1 "
- 6/9 "
- 6/16 TD 3217'  
Lansing 2902'  
Granite 3216'  
5" @ 2994'  
Perf Lans. 6000 acid  
Pump 25 Oil Pot.  
40<sup>9</sup> Gr.  
Comp.

**COMPLETED**

Map No. \_\_\_\_\_ Sec. 29 Twp. 14 R. 13W

Well No. 3 Opdycke

John Braden \_\_\_\_\_ Company

**FIRST REPORT** \_\_\_\_\_ Contractor

NW/C

SECTION PLAT

330 Ft. from N. Line

\_\_\_\_\_ Ft. from S. Line

\_\_\_\_\_ Ft. from E. Line

330 Ft. from W. Line

o			

Russell County

Location \_\_\_\_\_

Rig up \_\_\_\_\_

Drilling and Remarks:

surface hole

RECORD

Cased \_\_\_\_\_ in., \_\_\_\_\_ ft.

Sand \_\_\_\_\_

Gas \_\_\_\_\_

Oil \_\_\_\_\_

Total Depth \_\_\_\_\_

PRODUCTION

1st 24 hrs. Nat. \_\_\_\_\_

1st 24 hrs. after shot \_\_\_\_\_

Gas \_\_\_\_\_ Cu. Ft.

Dry Hole \_\_\_\_\_

Abandoned \_\_\_\_\_

Date

MAR 24 1948 19 \_\_\_\_\_

S. J. LEWIS Scout

Map No. 72 Sec. 29 Twp. 14 R. 13W

Well No. 3 Opdycke

John Braden Company

COMPLETE Contractor

NW/C

E. 1964  
SECTION PLAT

330 Ft. from N. Line

\_\_\_\_\_ Ft. from S. Line

\_\_\_\_\_ Ft. from E. Line

330 Ft. from W. Line

o			

Russell County

Location \_\_\_\_\_

Rig up \_\_\_\_\_

Drilling and Remarks:

*Lease 2902  
Grants 2216  
50 2994.  
Per. Lease  
6000 acid  
Pump 25 oil pd  
40 2994*

RECORD

Cased \_\_\_\_\_ in., \_\_\_\_\_ ft.

Sand \_\_\_\_\_

Gas \_\_\_\_\_

Oil  \_\_\_\_\_

Total Depth 3217

PRODUCTION

1st 24 hrs. Nat. \_\_\_\_\_

1st 24 hrs. after shot \_\_\_\_\_

Gas \_\_\_\_\_ Cu. Ft.

Dry Hole \_\_\_\_\_

Abandoned \_\_\_\_\_

Date

JUN 16, 1948

19

S. J. LEWIS Scout