

Section 29 Township 14 Range 13 W

Well No. # 6 Garter

Company Cities Service Oil Co.

NORTH

				0			

WEST

EAST

SOUTH

Russell

KANSAS

Sec. 29 Twp. 14 R. 13 W

Well No. # 6 Carter Farm

Cities Service Oil Co. Company

Hall Gurney Pool Contractor


330 Ft. from N. Line

_____ Ft. from S. Line

_____ Ft. from E. Line

330 Ft. from W. Line

NW NW NE

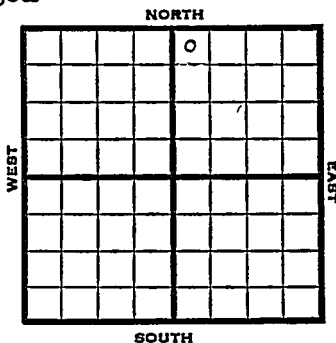

1951 Elev. 1766⁺ REPORT

7/11 Spud 7-4-51
8" @ 280
Drlg. 1990'

8/8 Spud 7-4-51
Oil Well TD 3120
8" @ 280
Tarkio 2270
Top 2582
Lans. 2904
TD 3120 5" @ 3120 GO to 3100
34/2939-48 1000 A 33/3065-73
1000 A 34/2994-3003 1000 A
52/2916-31 1500 A P 8 bo 69 bwpd
17/3081-85 20/3033-38 500 A
P/4 bo 46 bwpd PB 2345 82/2316-30
1000 A Comp. 41 bo 20 bwpd

COMPLETED

County **Russell** State **Kansas**

Spc. **29** (Blk. **14**) (Sur. **13W**) (Twp.) (Rge.) Map No.

Operator **Cities Service Oil Co.**

Well No. **6** Farm **Carter**

Elev. **1766** Location **NW NW NE**

330 Ft. From **N** Line **NE**
330 Ft. From **W** Line **Quarter**

Ist. Report **JUL 11 1951**

Completion _____

Remarks _____

Spudding Date **7-4-51**

Drlg. Data **Hall Gurney - pool**

8" @ 280 Drlg. 1990

J. E. TYRA

County Russell State Kansas

Sec. 29 (Blk. 14) (Sur. 13W) (Twp.) Map No.

Operator Cities Service Oil

Well No. 6 Farm Carter

Elev. 1766 Location NW NW NE

		o			

COMPLETE

330 Ft. From N Line NE

330 Ft. From W Line Quarter

1st. Report

Completion AUG 8 1951

Remarks Hall-Gurney Pool

Spudding Date 7-4-51

Drig. Data Oil well TD 3120

8" @ 280 Tarkio 2270 Top. 2582

Lans. 2904 TD 3120 5" @ 3120 CO to

3100 34/ 2939-48 1000 A 33/ 3065-73

1000 A 34/ 2994-3003 1000 A 52/ 2916-

31 1500 A P/ 8 bo 69 bwpd

17/ 3081-85 20/ 3033-38 500 A

P/ 4 bo 46 bwpd PB 2345 82/ 2316-30

1000 A Comp. 41 bo 20 bwpd

J. E. TYRA