


Butler

Section 25 Township 29 Range 6E

Well No. #1 Price _____

Company Vickers

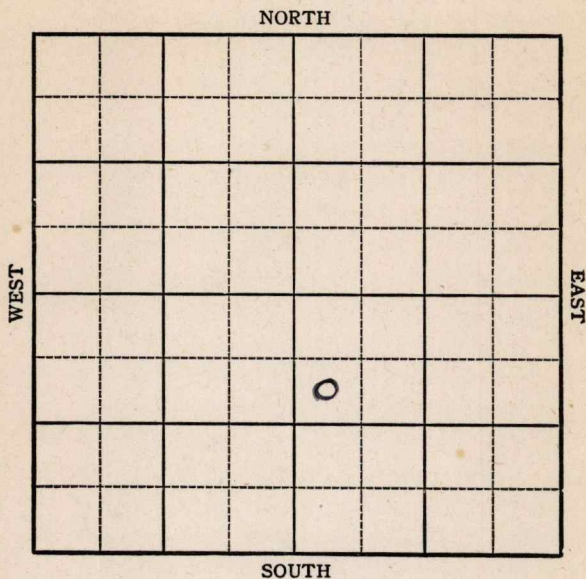

KANSAS

Butler

Sec. 25 Twp. 29 R. 6E

Well No. #1 Price Farm

Vickers Company

Miscellaneous


990 Ft. from N. Line

Ft. from S. Line

Ft. from E. Line

330 Ft. from W. Line

Des. 1394

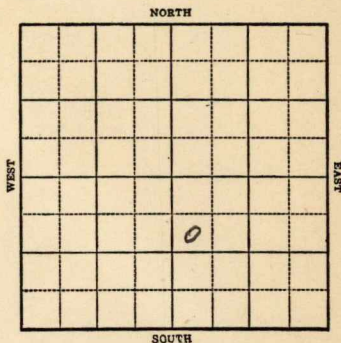

1944

REPORT

2/23	Location
3/1	"
3/8	"
3/16	"
3/22	"
3/29	"
4/5	Drlg. 100
4/12	Drlg. 378 15" @ 377
4/19	Drlg. 1415
4/26	Drlg. 1485
5/3	10" @ 1562 Drlg. 1910'
5/10	8" @ 2136 KC 2138 Drlg. 2434
5/17	Miss. 2815 Total Depth 2850

ABANDONED

Butler

KANSAS

Map No. 11 Sec. 25 Twp. 29 R. 6EWell No. 1 PriceVickers


Company

FIRST REPORT

Contractor

SW NW SE

SECTION PLAT

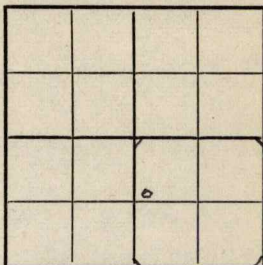990 Ft. from N. Line Ft. from S. Line Ft. from E. Line330 Ft. from W. Line

Miscellaneous

Location XRig up

Drilling and Remarks:

RECORD

Cased in., ft.Sand Gas Oil Total Depth

PRODUCTION

1st 24 hrs. Nat. 1st 24 hrs. after shot Gas Cu. Ft.Dry Hole Abandoned

Date

FEB 23 1944 19S. J. LEWIS Scout

KANSASPool Name MiscellaneousMap No. 11 Sec. 25 Twp. 29 R. 6EWell No. 1 PriceVickers

Company

ABANDONED

Contractor

SW NW SE

SECTION PLAT

990


Ft. from N. Line

Ft. from S. Line

Ft. from E. Line

330

Ft. from W. Line

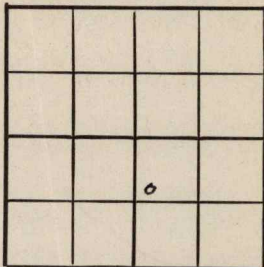Butler County

Location

Rig up

Drilling and Remarks:

Mis 2815

RECORD

Cased _____ in., _____ ft.

Sand _____

Gas _____

Oil _____

Total Depth 2858

PRODUCTION

1st 24 hrs. Nat. _____

1st 24 hrs. after shot _____

Gas _____ Cu. Ft.

Dry Hole _____

Abandoned _____

Date

MAY 17 1944 19S. J. LEWIS

Scout