KANSAS


Form 51—5M—7-40—Palace

Russell

Section 31 Township 14 Range 13-W

Well No. #2 Miller

Company R. H. Shields

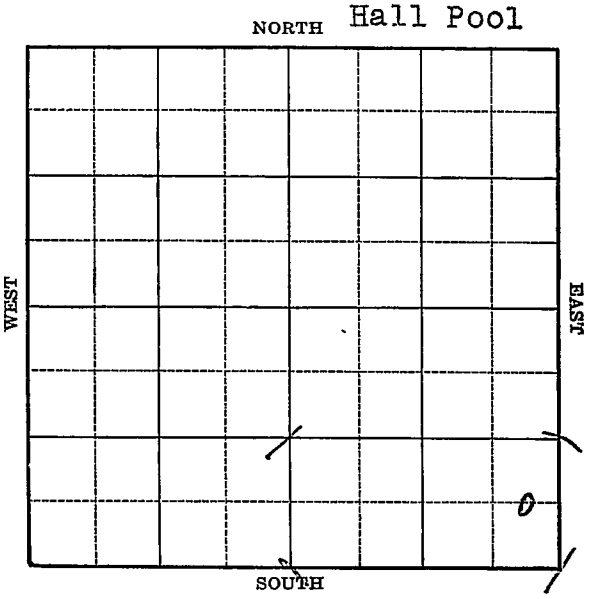

FORM 252-A 5M 7-40 PETROL KANSAS Russell

Sec. 31 Twp. 14 R. 13-W

Well No. #2 Miller Farm

R. H. Shields Company


(Hall)

_____ Ft. from N. Line

660 Ft. from S. Line

330 Ft. from E. Line

_____ Ft. from W. Line

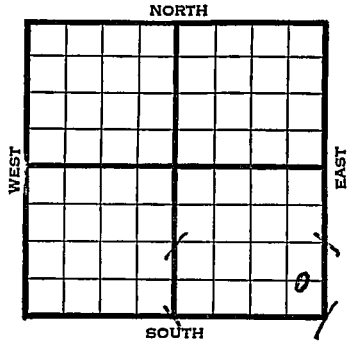

Elev. 1746

1940	REPORT
9/25	Location
10/3	Cable rig.
10/10	" "
10/17	" "
10/24	Spud 100'
10/31	20" - 32' 12" - 370'
	Anhy 688' 10" - 697'
	Drlg. 1115'
11/7	SS/gas 1555' Drlg. 2000'
11/14	8" - 2327' S/Gas 2360'
	Drlg. 2455'
11/21	Topeka 2585' Dodge 2827'
	SO & G. 2833-40' 1000' oil.
	7" - 2843' Lans. 2894-95' T.D.
	Run 5".
11/27	5" - 2984' WOC.
12/5	Pay 2913-23' T.D. 1000' oil 2½
	hours. P.B.P.
	OVER

1940
12/11 Lans. 2894'
5" - 2894'
T.D. 2926'
3000 acid.
Pump & flow 1763 bbls., potential
38.6 Gravity

COMPLETED

Form 26—200 Bks.—1-40—Palace. Russell KANSAS

Map No. 72 Sec. 31 Twp. 14 R. 13W

Well No. 2 Miller

R. H. Shields Company

Contractor

FIRST REPORT

C E L SE SE

_____ Ft. from N. Line


660 Ft. from S. Line

330 Ft. from E. Line

_____ Ft. from W. Line

HALL POOL

SECTION PLAT

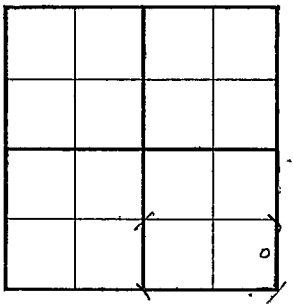

Location X

Rig up

Drilling and Remarks:

RECORD

Cased _____ in., _____ ft.

Sand

Gas

Oil

Total Depth

PRODUCTION

1st 24 hrs. Nat.

1st 24 hrs. after shot

Gas _____ Cu. Ft.

Dry Hole

Abandoned

Date

SEP 25 1940 19

S. J. LEWIS Scout

Form 26—200 Bks.—1-40—Palace Russell KANSAS

Map No. 72 Sec. 31 Twp. 14 R. 13W

Well No. 2 Miller

R. H. Shields Company

Contractor

COMPLETED

C E L SE SE

Ft. from N. Line


660 Ft. from S. Line

330 Ft. from E. Line

Ft. from W. Line

HALL POOL

SECTION PLAT

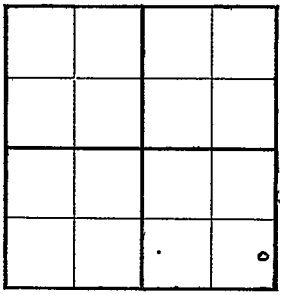

Location

Rig up

Drilling and Remarks:

Lans 2894
5" C 2894
3000 acid
P.F. 1763 B.B.
38.6 Gr

RECORD

Cased in., ft.

Sand

Gas

Oil

Total Depth 2926

PRODUCTION

1st 24 hrs. Nat.

1st 24 hrs. after shot

Gas Cu. Ft.

Dry Hole

Abandoned

Date

DEC 11 1940 19

S. J. LEWIS Scout