


Map No. K Sec. 28 Twp. 29 R. 6

Well No. 2 Steinhoff Farm
Gled Oil Co. Company

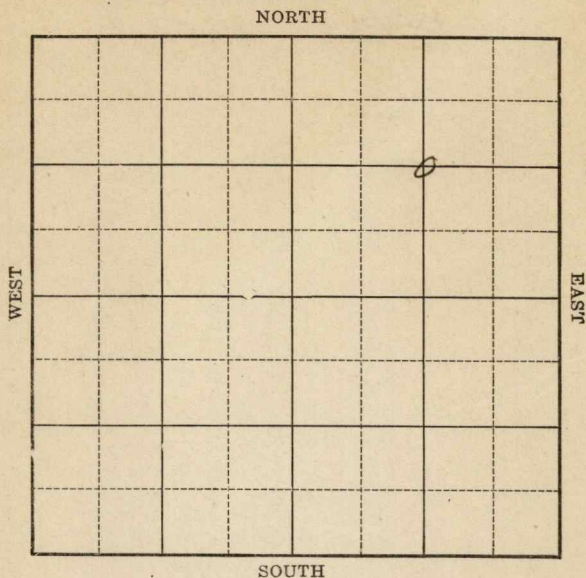

Location _____

Drilling Remarks _____

Rig Up _____

Drilling Remarks _____

RECORD

Cased _____ in. _____ ft.

Sand _____

Gas _____

Oil _____

Total Depth _____

PRODUCTION

1st 24 hrs. Nat. _____

1st 24 hrs. after shot _____

Gas _____ cu. ft.

Dry Hole _____

Abandoned _____

Butler Co

Map No. Kansas Sec. 28 Twp. 29 R. 6


Well No. 2 Steinhoff Farm
Gled Oil Company

1320 Ft. from N. Line

..... Ft. from S. Line

1320 Ft. from E. Line

..... Ft. from W. Line

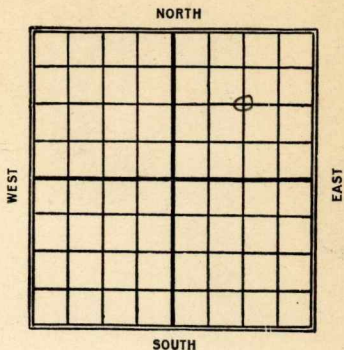


Date	REPORT
1926 6/9	R.O.G.
6/18	Rigging up
6/25	Spudding
6/30	only 450
7/8	" 750
7/15	" 1030
7/22	" 1300
7/28	" 1600
8/4	" 1800
8/11	P.D. 1800
8/18	Dly 1850
8/25	" 2000
8/31	8" 2210
sand 2250-65- 10 bbl show only 2265	
9/15	top line 2800'-Dly 2875
9/22	I.D. 315-3'-H.F.W.
Will plug back to 2255	
9/29	-----
10/6	sand 2245-2255- (over)

Top line 2800'

J.D. 3153-H.F.W.

P.B. to 2255'

20/25-barrels

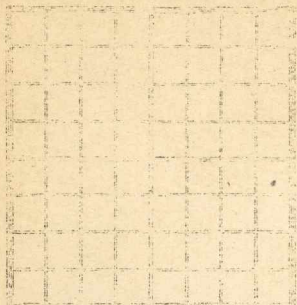






Butler Co

K11 KANSAS Map No. _____ Sec. *28* Twp. *29* R. *6*

Well No. *2 Steinhoff* _____
465 Oil Co _____ Company

Contractor _____

FIRST REPORTS

SECTION PLAT

1320 Ft. from N. Line

_____ Ft. from S. Line

1320 Ft. from E. Line

_____ Ft. from W. Line

			⊙

Formerly owned by Carter Oil Co

Location _____

Rig up _____

Drilling and Remarks:

50 ft

RECORD

Cased _____ in., _____ ft.

Sand _____

Gas _____

Oil _____

Total Depth _____

PRODUCTION

1st 24 hrs. Nat. _____

1st 24 hrs. after shot _____

Gas _____ Cu. Ft.

Dry Hole _____

Abandoned _____

Date

JUN 9 1926

192

CHAS. L. SHERWOOD


Scout

Butler

11 KANSAS Map No. Sec 28 Twp. 29 R. 6

Well No. 2 Stainheff Farm
Boled out Co. Company

NORTH

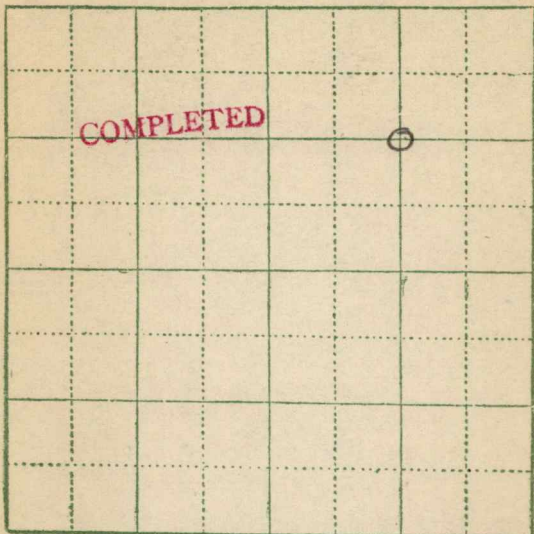

B20
X
1320

SOUTH

Location _____

Rig up _____

Drilling and Remarks:

Sand 2745-2755'
th 2800'
T.D. 3153 ft. Stopped
Back to 2755'
24 25 lbs.

RECORD

Cased _____ in., _____ ft.
Sand _____
Gas _____
Oil _____
Total Depth 3153

PRODUCTION

1st 24 hrs. Nat. _____
1st 24 hrs. after shot _____
Gas _____ Cu. Ft. _____
Dry Hole _____
Abandoned _____

Date

OCT 6 1926

192

CHAS. L. SHERWOOD

Scout