

Russell

FORM 51

KANSAS

Section 27 Township 14 Range 13W

Well No. #1 Rogg

Company Jayhawk Drlg.

NORTH

| | | | | | | | |
|--|--|--|--|--|--|--|---|
| | | | | | | | 0 |
| | | | | | | | |
| | | | | | | | |
| | | | | | | | |
| | | | | | | | |
| | | | | | | | |
| | | | | | | | |
| | | | | | | | |

WEST

EAST

SOUTH

Russell

KANSAS

| | | |
|------------|------------|-------------|
| SEC. 27 | TWP. 14 | R. 13W ✓ |
|------------|------------|-------------|

WELL NO. #1 Rogg FARM

COMPANY Jayhawk Drlg.

CONTRACTOR Jayhawk Drlg.


Hall-Gurney Pool NORTH

330 Ft. from N. Line

Ft. from S. Line

330 Ft. from E. Line

Ft. from W. Line

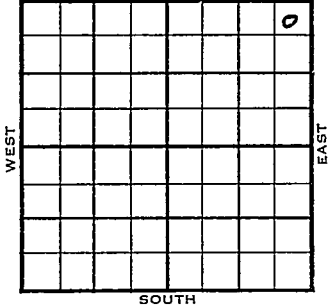

NE NE NE

| | | |
|------|--------------------|--------|
| 1954 | ELEVATION 1750' | REPORT |
|------|--------------------|--------|

3/31 RUCT
4/7 15" @ 43 10" @ 390 Anhy 680
8" @ 690 Drlg. 1025'

5/5 Spud 3-30-54
Oil Well
TD 2318'
15" @ 43'
10" @ 390'
Anhy 680',
8" @ 690'
Tarkio 2260'
TD 2318'
5" @ 2318'
CO to 2299'
28/ 2260-67 frac.
Comp 25 bopd.

COMPLETED


County Russell State Kansas

Sec. 27 (Blk. Twp.) 14 (Sur. Rge.) 13W Map No.

Operator Jayhawk Drlg.

Well No. 1 Farm Rogg

Elev. _____ Location NE NE NE

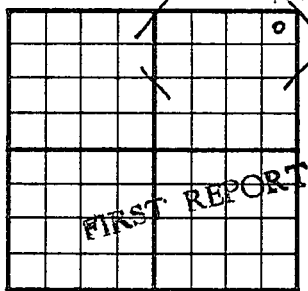

330 Ft. From N Line NE

330 Ft. From E Line Quarter

Ist. Report MAR 31 1954

Completion _____

Remarks _____

Jayhawk Drlg. - Contr.

Spudding Date _____

Drlg. Data Hall-Gurney Pool

RUCT

J G. MCGEHEE

County Russell State Kansas

Sec. 27 (Blk. 14 (Sur. Rge.) 13W Map No.

Operator Jayhawk Drlg.

Well No. 1 Farm Rogg

Elev. 1750 Location NE NE NE

| | | | | | | | | | |
|--|--|--|--|--|--|--|--|--|--|
| | | | | | | | | | |
| | | | | | | | | | |
330 Ft. From N Line NE

330 Ft. From E Line Quarter

1st. Report

Completion MAY 5 1954

Remarks Hall-Gurney Pool

Jayhawk Drlg. -Contr.

Spudding Date 3-30-54

Drlg. Data Oil well TD 2318

15" @ 43 10" @ 390 Anhy 680 8" @ 690

Tarkio 2260 TD 2318 5" @ 2318

CO to 2299 28/ 2260-67 frac

Comp. 25 bopd

J. G. McGEHEE