


Section 27 Township 14 Range 13W

Well No. #4 Rogg

Company Magnolia Petr.

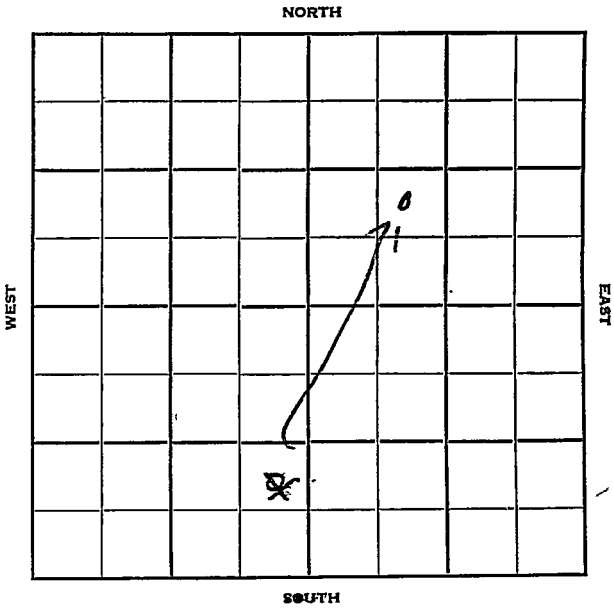

Sec. 27 Twp. 14 R. 13W

Well No. #4 Rogg Farm _____

Magnolia Petr. Company _____

Contractor _____

_____ Ft. from N. Line


990 Ft. from S. Line

~~330~~ Ft. from E. Line

990 Ft. from W. Line

~~NE SW NE~~

~~NE SE SW~~

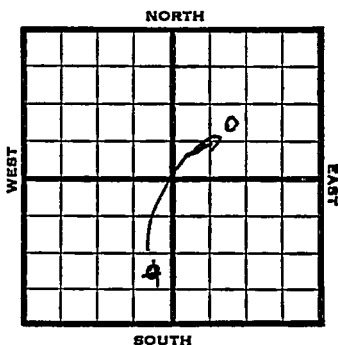

1952 Elev. 1728' REPORT

11/19 Spud 11-17-52
8" @ 356'

11/27 Tarkio 2300
RTD 2400
5" @ 2399'

12/4 NR

12/11 Testing

12/18 Testing

12/25 " "

12/30 - Spud 11-17-52
Oil Well
TD 2400
8" @ 356
Tarkio 2300
TD 2400
5" @ 2399
CO to 2391
23/2375-80 44/2346-68 1 bswph
2 1/2 hrs., SP 2370 sq 2346-68
CO to 2341 88/2315-38 Hydro.
1 1/2 bo 3 bwph 20 hrs. S/4 bo
14 bsw 7 hrs. PB 2293
104/2262-81, FU 800' wtr. Hydro

OVER

Kansas

Map No. _____ Sec. 27 Twp. 14 R. 13W

Well No. 4 Rogg

Magnolia Pet. Company

CORRECTION

Contractor

NE SW NE

SECTION PLAT

_____ Ft. from N. Line

990 Ft. from S. Line

_____ Ft. from E. Line

990 Ft. from W. Line

		o	

Russell County

Location _____

Rig up _____

Drilling and Remarks:

Reported
NE SE SW

RECORD

Cased _____ in., _____ ft.

Sand _____

Gas _____

Oil _____

Total Depth _____

PRODUCTION

1st 24 hrs. Nat. _____

1st 24 hrs. after shot _____

Gas _____ Cu. Ft.

Dry Hole _____

Abandoned _____

Date

DEC 3 1952

J. G. McGEHEE

Scout

#4 Rogg

(Information Brought Forward)

1952

12/30

S/10 bo 4 bw 5 hrs.

PB 2257, 42/2246-53, S/2 bo

4 gwph Hydro. 2246-53

S/2 3/4 boph 5 hrs.

CO to 2292 S/2 bo 2 bwph 4 hrs

Comp. 51 bopd 25 bw

COMPLETED