

KANSAS


Form 51—5M—11-38—Palace

Russell

Section 28 Township 14 Range 13-W

Well No. #4 Colliver

Company Skelly Oil

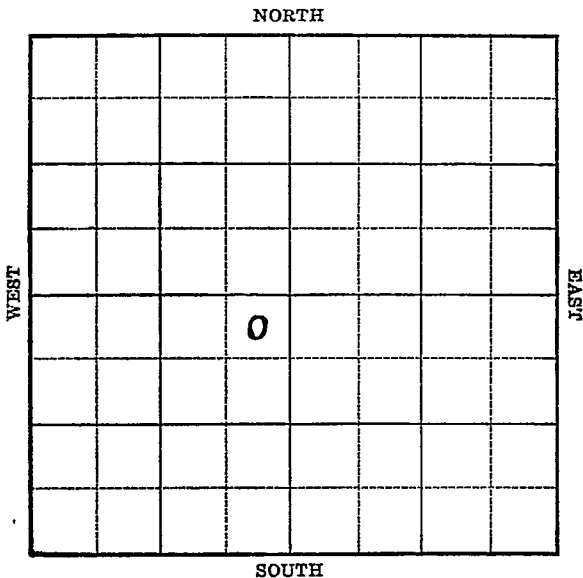

Russell

Sec. 28 Twp. 14 R. 13-W

Well No. #4 Colliver Farm

Skelly Oil _____ Company

(Letch)


330 Ft. from N. Line

_Ft. from S. Line

330 Ft. from E. Line

Ft. from W. Line

Elev. 1727

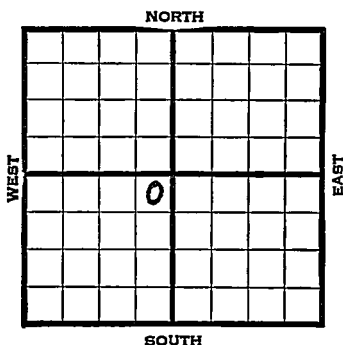

1939	REPORT
7/26	Rotary.
8/3	13" - 297' Drlg. 955'
8/10	Drlg. 2569'
8/17	Lans. 2859' S.O. 2874-76' T.D. 6" - 2874' RUST.
8/24	T.D. 2900' 2000' oil. Shut down
8/31	" " " " " "
9/7	6000 acid. Pump 270 bbls. oil 7 hours.
9/14	Pump 302 bbls. 8 hours.
9/20	Lans. 2859' 6" - 2874' T.D. 2900' 6000 acid. Pump 1158 bbls.
	COMPLETED

Map No. 72 Sec. 28 Twp. 14 R. 13WWell No. 4 ColliverSkelly Oil

Company

Contractor

FIRST REPORT

NE SW

SECTION PLAT

	o		

330 Ft. from N. Line Ft. from S. Line330 Ft. from E. Line Ft. from W. Line

Letsch Pool

Location Rig up

Drilling and Remarks:

Rotary

RECORD

Cased in., ft.Sand Gas Oil Total Depth

PRODUCTION

1st 24 hrs. Nat. 1st 24 hrs. after shot Gas Cu. Ft.Dry Hole Abandoned

Date

JUN 26 1939

19

S. J. LEWIS

Scout

Map No. _____ Sec. 28 Twp. 14 R. 13WWell No. 4 ColliverSkelly Oil

Company _____

Contractor _____

COMPLETED**NE SW**330 Ft. from N. Line

_____ Ft. from S. Line

330 Ft. from E. Line

_____ Ft. from W. Line

SECTION PLAT

	6		

LETSCH POOL

Location _____

Rig up _____

Drilling and Remarks:

*Leas. 2859**6" C 2874**6000 acil**Pump 1158***RECORD**

Cased _____ in., _____ ft.

Sand _____

Gas _____

Oil _____

Total Depth 2900**PRODUCTION**

1st 24 hrs. Nat. _____

1st 24 hrs. after shot _____

Gas _____ Cu. Ft.

Dry Hole _____

Abandoned _____

Date

SEP 20 193919S. J. LEWIS Scout