


Section 5 Township 33 Range 4E

Well No. #1 Hoornbeck *(Hornbeck)*

Company Laura Jane Oil

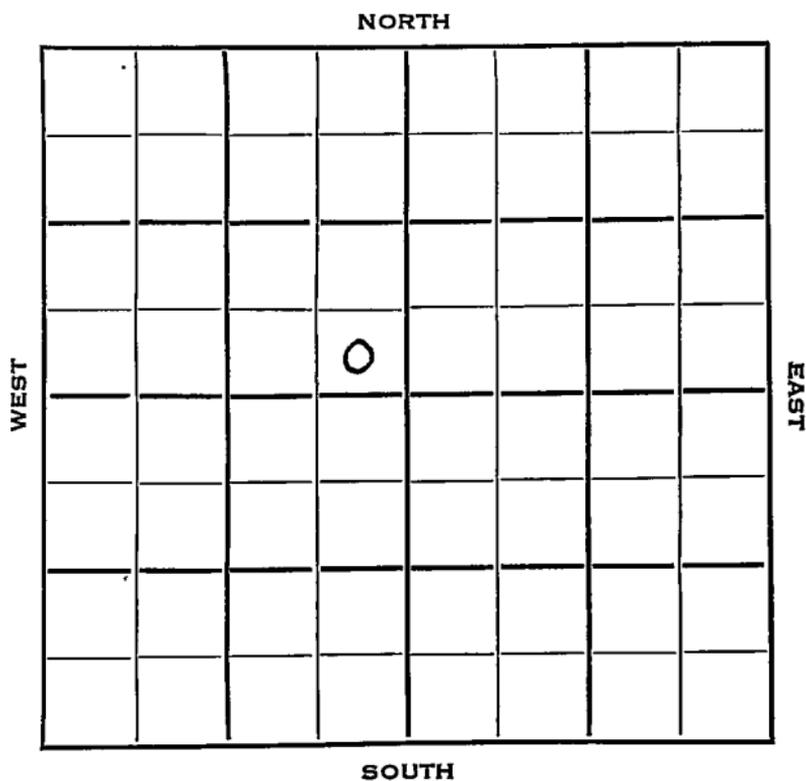

Cowley
33

KANSAS
4E



Sec. 5 Twp. _____ R. _____

Well No. #1 Hoornbeck Farm _____

Laura Jane Oil Company _____


Laura Jane Contractor _____
Wildcat

_____ Ft. from N. Line

330 Ft. from S. Line

330 Ft. from E. Line

_____ Ft. from W. Line

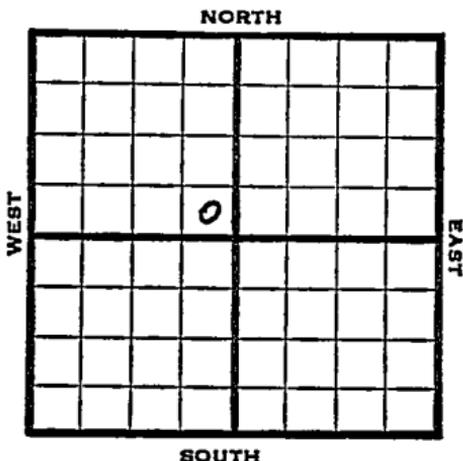

SE SE NW

Texas - DHM

1953

Elev. 1212' REPORT

5/6

Spud 5-2-53

8" @ 71

Drlg. 134

6/10

Spud 5-2-53 Oil well TD 3189
8" @ 71 Stal. 2129 Layton 2517
DST 2518-24 rec 308' SW 860#
KC 2694 Oswego 2879
DST 2821-35 open 1 hr rec 5' OGM
60' SOCW 910# Bart 3166
TD 3189 5" @ 3173 CO to 3189
FU 200' fluid 12 hr. PB 3185
Hydro. F/6 BOFH
Comp. 234 BOPD

COMPLETED

