
FORM 51 5M 2-38 TPCO. Russell KANSAS

Section 27 Township 14 Range 13-W

Well No. 2 Rogg

Company Magnolia

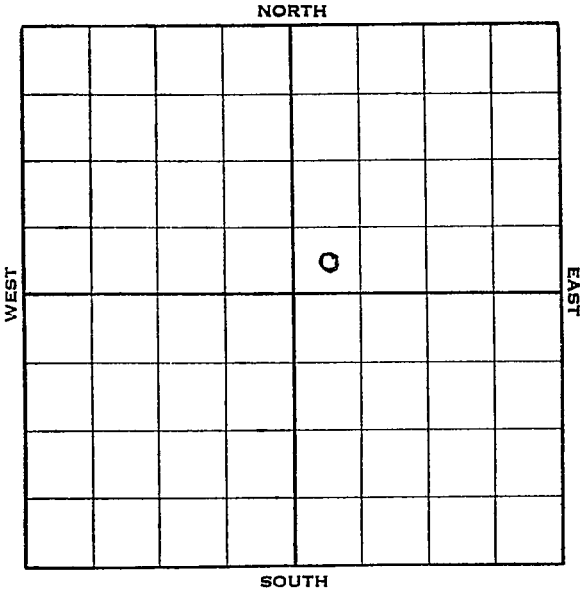


Form 252-A—5M—9-37 KANSAS Russell

Sec. 27 Twp. 14 R. 13-W

Well No. #2 Rogg Farm

Magnolia Company

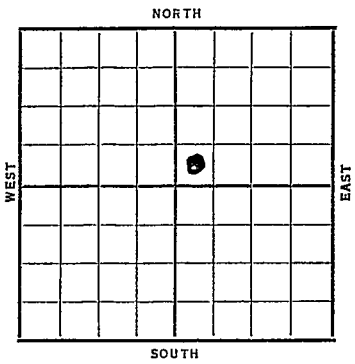

____ Ft. from N. Line

330 Ft. from S. Line

____ Ft. from E. Line

330 Ft. from W. Line

Elev. 1744

Date	REPORT
1938	
2/9	B.R.R.
2/18	10" @ 385'. Drlg. 1520'.
2/26	Coring 2874'.
3/4	Lans. 2862'. T.D. 2883'.
	7" @ 2881'. S.O. RUST.
3/11	T.D. 2886'. Swab 3½ oil per hr.
3/16	7" @ 2881'.
	Lans. 2862'.
	T.D. 2886'.
	2000 acid.
	Potential 1718 bbls.
	COMPLETED

Form 26—1M Bks.—2-29

Russell KANSAS

Map No. _____ Sec. 27 Twp. 14 R. 13W

Well No. 2 Rogg

Magnolia Company

FIRST REPORT Contractor

SW NE


_____ Ft. from N. Line

330 Ft. from S. Line

_____ Ft. from E. Line

330 Ft. from W. Line

SECTION PLAT

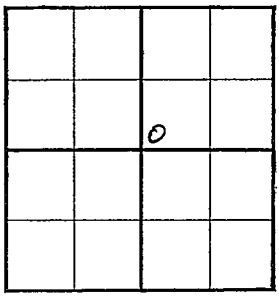

Location _____

Rig up _____

Drilling and Remarks:

BRR

RECORD

Cased _____ in., _____ ft.

Sand _____

Gas _____

Oil _____

Total Depth _____

PRODUCTION

1st 24 hrs. Nat. _____

1st 24 hrs. after shot _____

Gas _____ Cu. Ft.

Dry Hole _____

Abandoned _____

Date

FEB 9 1938 19

H. D. Hatfield Scout

Form 26—1M Bks.—2-29

Russell KANSAS

Map No. 72 Sec. 27 Twp. 14 R. 13W

Well No. 2 Rogg

Magnolia Company

Contractor

COMPLETED

SW NE


Ft. from N. Line

330 Ft. from S. Line

Ft. from E. Line

330 Ft. from W. Line

SECTION PLAT

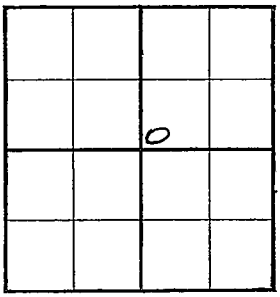

Location

Rig up

Drilling and Remarks:

2000 acid

Pot 1718

RECORD

Cased 7 in., 2881 ft.

~~Sand~~ Lans 2862

Gas

Oil

Total Depth 2886

PRODUCTION

1st 24 hrs. Nat.

1st 24 hrs. after shot

Gas Cu. Ft.

Dry Hole

Abandoned

Date

MAR 16 1938 19

E. D. Hatfield Scout