

O.W.W.O.

FORM 51 5M 2-38 TPCO.


Russell

KANSAS

Section 28 Township 14 Range 13-W

Well No. 2 Colliver

Company Skelly Oil

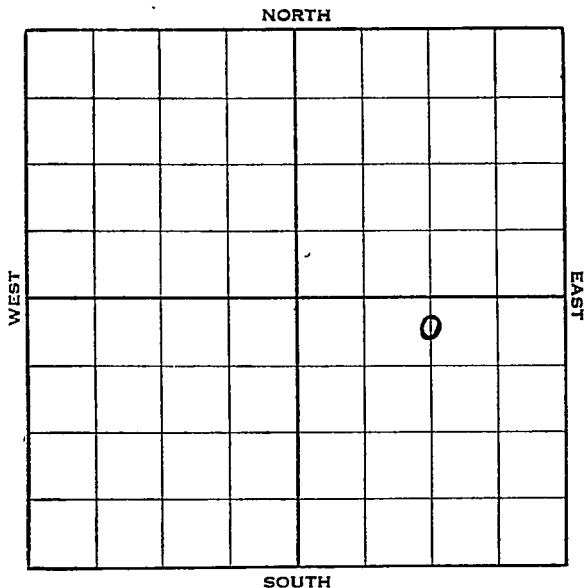

KANSAS

Russell

O.W.W.O.

Sec. 28 Twp. 14 R. 13-W

Well No. #2 Colliver Farm

Skelly Oil Company


330 Ft. from N. Line

_____ Ft. from S. Line

1320 Ft. from E. Line

_____ Ft. from W. Line

Elev. 1725

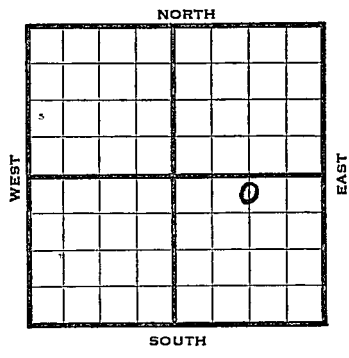

1938	REPORT
8/3	Mat'l.
8/12	"
8/19	"
8/26	"
9/2	"
9/9	"
9/16	R.U.C.P.
9/23	16" - 165'. 13" - 370'. WOG.
9/30	Anhy 673'. 10" - 675'.
	T. D. 1130' Fsg.
10/7	S.S.G. 1890-1900'. Dlg. 2150'.
10/14	8" - 2350'. S. O. 2578-83'.
	Dlg. 2785'.
10/21	Lans. 2848'. 7" - 2878'.
	Coring 2894'. S. O.

OVER

1938

10/26 7" - 2878'..
Lans. 2848'.
T. D. 2903'.
8000 acid.
Potential 1338 bbls.

COMPLETED

O.W.W.O.

1951
12/12

Oil well TD 2258'
Indian Cave sd. 2222'
KC 2848'
OTD 2903'
7" @ 2878' DD Arb. 3124-54'
PB 2796' 24/2588-94 500 A
S/20 GW 8 hr. PB 2313'
24/2279-85 Hydro. S/2 BWPH 6 hr.
PB 2260' 20/2235-40 Hydro.
P/11 BO $\frac{1}{2}$ BW 24 hr. PB 2230'
12/ 2230-26' Hydro P/16 BO
15 BWPD' DD 2258'
Comp. 14 BOPD 42% water.

FIRST REPORT
COMPLETED

Map No. 72 Sec. 28 Twp. 14 R. 13 WWell No. 2 ColliverSkelly Oil

Company

Contractor

FIRST REPORT

SECTION PLAT

C N L SE

330 Ft. from N. Line

_____ Ft. from S. Line

1320 Ft. from E. Line

_____ Ft. from W. Line

		○	

Location _____

Rig up _____

Drilling and Remarks:

Matl.

RECORD

Cased _____ in., _____ ft.

Sand _____

Gas _____

Oil _____

Total Depth _____

PRODUCTION

1st 24 hrs. Nat. _____

1st 24 hrs. after shot _____

Gas _____ Cu. Ft.

Dry Hole _____

Abandoned _____

Date

AUG 3 - 1938

19

H. D. Hatfield

Scout

Map No. _____ Sec. 28 Twp. 14 R. 13WWell No. 2-ColliverSkelly Oil Company

Contractor _____

G NL SE

COMPLETED

SECTION PLAT

		0	

330 Ft. from N. Line

_____ Ft. from S. Line

1320 Ft. from E. Line

_____ Ft. from W. Line

Location _____

Rig up _____

Drilling and Remarks:

8000 AcidPOT 1338

RECORD

Cased 7 in., 2878 ft.Sand LENS 2848

Gas _____

Oil _____

Total Depth 2903

PRODUCTION

1st 24 hrs. Nat. _____

1st 24 hrs. after shot _____

Gas _____ Cu. Ft.

Dry Hole _____

Abandoned _____

Date

OCT 26 1938

19

H. D. Hatfield

Scout

County Russell State Kansas

Sec. 28 (Blk. Twp.) 14 (Sur. Rge.) 13W Map No.

Operator Skelly Oil

Well No. 2 Farm Colliver

Elev. 1725 Location C N L. N $\frac{1}{2}$ SE

~~FIRST REPORT~~
~~COMPLETE~~

330 Ft. From N Line SE

1320 Ft. From E Line Quarter

Ist. Report DEC 1 2 1951

Completion

Remarks ORIGINAL

~~NO RECORD~~

Spudding Date

Drlg. Data Oil well TD 2258 Letsch Pool

Indian Cave sd. 2222 KC 2848 OTD 2903

7" @ 2878 DD Arb. 3124-54 PB 2796

24/ 2588-94 500 A S/ 20 gw 8 hr.

PB 2313 24/ 2279-85 Hydro. S/ 2 bwph

6 hr. PB 2260 20/ 2235-40 Hydro.

P/ 11 bo $\frac{1}{2}$ bw 24 hr. PB 2230

12/ 2223-26 Hydro. P/ 15 bo 15 bwpd

DD 2258 Comp. 14 bopd 42% water

~~NO RECORD~~

~~NO RECORD~~

J. E. TYRA