


Section 28 Township 14 Range 13-W

Well No. 3 Colliver

Company Skelly Oil

NORTH Hall Pool

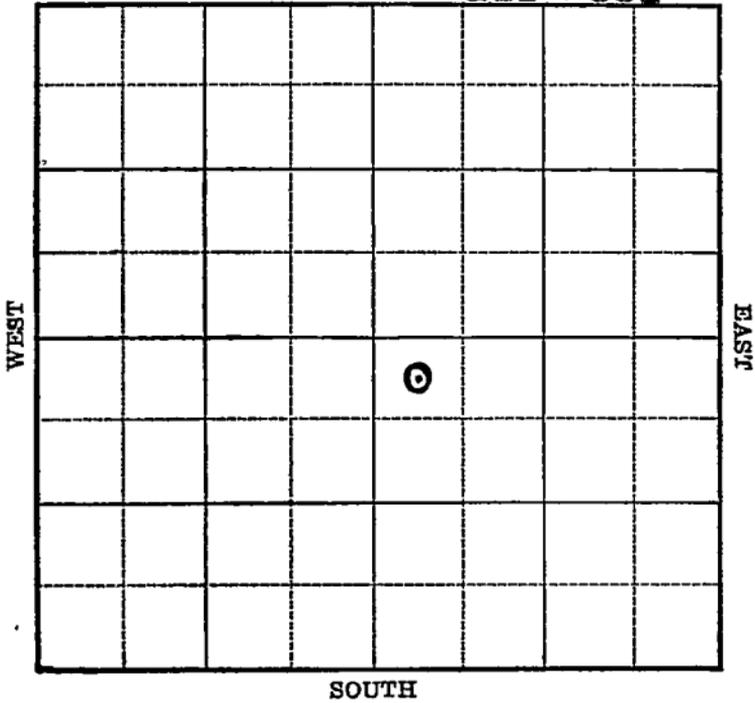

Sec. 28 Twp. 14 R. 13-W

Well No. #3 Colliver Farm

Skelly Oil Company

(Hall)


330 Ft. from N. Line

_____ Ft. from S. Line

_____ Ft. from E. Line

330 Ft. from W. Line

Elev. 1725

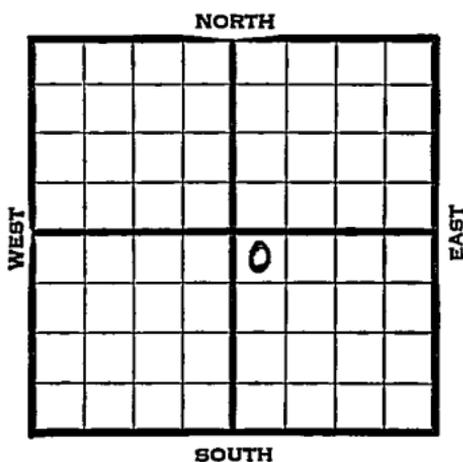

1939	REPORT
5/10	B.R.R.
5/19	S. H. 310' Reaming.
5/26	10" - 287' Drilling 1801'
6/7	Drilling 2726'
6/8	Lansing 2861½'
	T.D. 2897' 1200' 24 hrs.
6/14	Lans. 2861½'
	6-5/8" - 2879'
	T.D. 2897'
	6000 acid.
	Pump 499 bbls. 8 hours.
	Potential 1498 bbls.
	COMPLETED

Map No. _____ Sec. **28** Twp. **14** R. **13W**Well No. **3 Colliver****Skelly Oil**

Company

Contractor

FIRST REPORT

NW SE

330 Ft. from N. Line

_____ Ft. from S. Line

_____ Ft. from E. Line

330 Ft. from W. Line**Hall Pool****SECTION PLAT**

		o	

Location _____

Rig up _____

Drilling and Remarks:

BRR**RECORD**

Cased _____ in., _____ ft.

Sand _____

Gas _____

Oil _____

Total Depth _____

PRODUCTION

1st 24 hrs. Nat. _____

1st 24 hrs. after shot _____

Gas _____ Cu. Ft.

Dry Hole _____

Abandoned _____

Date

MAY 10 1939

19

S. J. LEWIS

Scout

Map No. 72 Sec. 28 Twp. 14 R. 13W

Well No. 3 Colliver

Skelly Oil Company

Contractor

COMPLETED

NW SE

330 Ft. from N. Line

_____ Ft. from S. Line

_____ Ft. from E. Line

330 Ft. from W. Line

SECTION PLAT

		0	

HALL POOL

Location _____

Rig up _____

Drilling and Remarks:

Loss 286 1/2
6 5/8" @ 2879
6000 acid
Pump 499 - 8 hrs
P 81498

RECORD

Cased _____ in., _____ ft.

Sand _____

Gas _____

Oil _____

Total Depth 2897

PRODUCTION

1st 24 hrs. Nat. _____

1st 24 hrs. after shot _____

Gas _____ Cu. Ft.

Dry Hole _____

Abandoned _____

Date

JUN 14 1939

S. J. LEWIS

Scout