

# KANSAS

Form 51—5M—7-39—Palace


Russell

Section 28 Township 14 Range 13-W

Well No. #5 Colliver

Company Skelly Oil

NORTH Letsch Pool

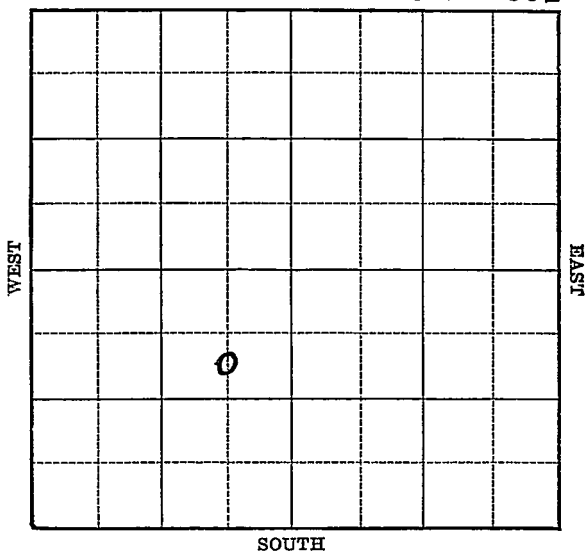



Russell **KANSAS**

Map No. \_\_\_\_\_ Sec. **28** Twp. **14** R. **13W**

Well No. **5 Colliver**

**Skelly Oil**

Company

Contractor

**FIRST REPORT**

**C S L N E S W**

**SECTION PLAT**

	o		

**990** Ft. from N. Line

\_\_\_\_\_ Ft. from S. Line

**660** Ft. from E. Line

\_\_\_\_\_ Ft. from W. Line

**LETSCH POOL**

Location \_\_\_\_\_

Rig up \_\_\_\_\_

Drilling and Remarks:

**Rotary**

**RECORD**

Cased \_\_\_\_\_ in., \_\_\_\_\_ ft.

Sand \_\_\_\_\_

Gas \_\_\_\_\_

Oil \_\_\_\_\_

Total Depth \_\_\_\_\_

**PRODUCTION**

1st 24 hrs. Nat. \_\_\_\_\_

1st 24 hrs. after shot \_\_\_\_\_

Gas \_\_\_\_\_ Cu. Ft.

Dry Hole \_\_\_\_\_

Abandoned \_\_\_\_\_

Date

**OCT 4 1939** 19

**S. J. LEWIS** Scout

Map No. 72 Sec. 28 Twp. 14 R. 13WWell No. 5 ColliverSkelly Oil

Company

Contractor

**COMPLETED****C S I NE SW**990 Ft. from N. Line

\_\_\_\_\_ Ft. from S. Line

660 Ft. from E. Line

\_\_\_\_\_ Ft. from W. Line

**SECTION PLAT**


**HALL POOL**

Location \_\_\_\_\_

Rig up \_\_\_\_\_

Drilling and Remarks:

*Kans. 2895.**7" @ 2895.**8000 c.c. oil**Pump 1482 P.S.***RECORD**

Cased \_\_\_\_\_ in., \_\_\_\_\_ ft.

Sand \_\_\_\_\_

Gas \_\_\_\_\_

Oil \_\_\_\_\_

Total Depth 2912.**PRODUCTION**

1st 24 hrs. Nat. \_\_\_\_\_

1st 24 hrs. after shot \_\_\_\_\_

Gas \_\_\_\_\_ Cu. Ft.

Dry Hole \_\_\_\_\_

Abandoned \_\_\_\_\_

Date

NOV 15 1939

19

S. J. LEWIS

Scout