


Section 28 Township 14 Range 13-W

Well Number #1 Giese

Company Shields et al

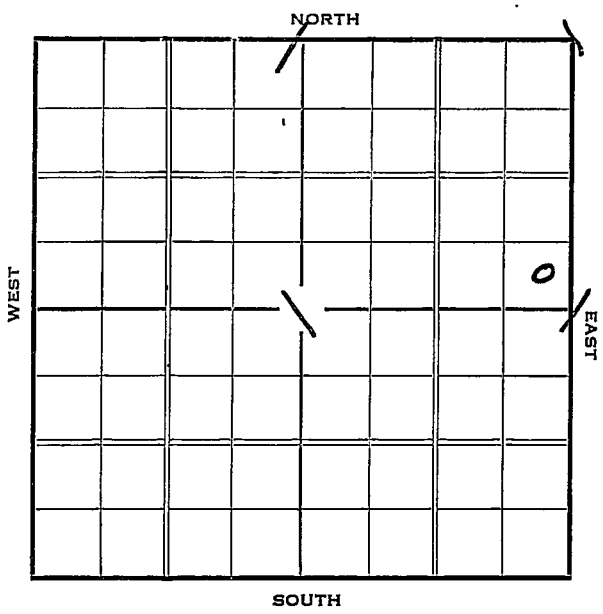


Sec. 28 Twp. 14 R. 13-WWell No. #1 Giese FarmShields etal Company

_____ Ft. from N. Line

330 Ft. from S. Line330 Ft. from E. Line

_____ Ft. from W. Line

Elev. 1746

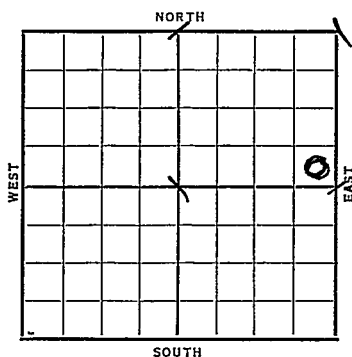

Date

REPORT

1937

10/13 BCR

10/22 "

10/29 15" @ 175'. Drlg. 245'.

11/5 Anhy 677'. 10" @ 687'.

Drlg. 800'.

11/12 Drlg. 1865'.

11/13 Tarkio lime 2245 Show oil 2245-50

Dlg. 2265 (Tel)

11/19 Sm. S.O. 2225'. Tarkio 2245'.

8" @ 2250'. Drlg. 2325'.

11/22 Kansas City 2877 7" 2895

Pay 2903-15 T.D. 2915

Filled up 1000 feet oil 1st hour

Total fill up 2000 feet

Cleaning out (Tel)

11/26 " " "

12/3 No test.

12/9 Acidized 5000 gallons

Potential 2145 bbls. Grav. ~~XXIX~~ 39.1
(Tel)

OVER

1937

12/8

7" @ 2895'.

K.C. 2877'.

T.D. 2915'.

5000 acid.

Potential 2145 bbls.

Gravity 39.1

COMPLETED

Map No. _____ Sec. 28 Twp. 14 R. 13WWell No. 1 GieseShields etal Company

Contractor

FIRST REPORT

SE NE

SECTION PLAT

			0

_____ Ft. from N. Line

330 Ft. from S. Line330 Ft. from E. Line

_____ Ft. from W. Line

Location _____

Rig up _____

Drilling and Remarks:

BCR

RECORD

Cased _____ in., _____ ft.

Sand _____

Gas _____

Oil _____

Total Depth _____

PRODUCTION

1st 24 hrs. Nat. _____

1st 24 hrs. after shot _____

Gas _____ Cu. Ft.

Dry Hole _____

Abandoned _____

Date

OCT 13 1937 19H. D. Hatfield Scout

Map No. 72 Sec. 28 Twp. 14 R. 13W

Well No. 1 Giese

Shields etal Company

~~COMPLETED~~ Contractor

SECTION PLAT

SE NE

_____ Ft. from N. Line

330 Ft. from S. Line

330 Ft. from E. Line

_____ Ft. from W. Line

			0

Location _____

Rig up _____

Drilling and Remarks:

5000 acid

POT- 2145

grav. 39.1

RECORD

Cased 7 in., 2895 ft.

Sand K.C. 2877

Gas _____

Oil _____

Total Depth 2915

PRODUCTION

1st 24 hrs. Nat. _____

1st 24 hrs. after shot _____

Gas _____ Cu. Ft.

Dry Hole _____

Abandoned _____

Date

DEC 8 - 1937 19

H. D. Hatfield

Scout