


Section 28 Township 14 Range 13-W

Well No. #14 Colliver

Company Skelly

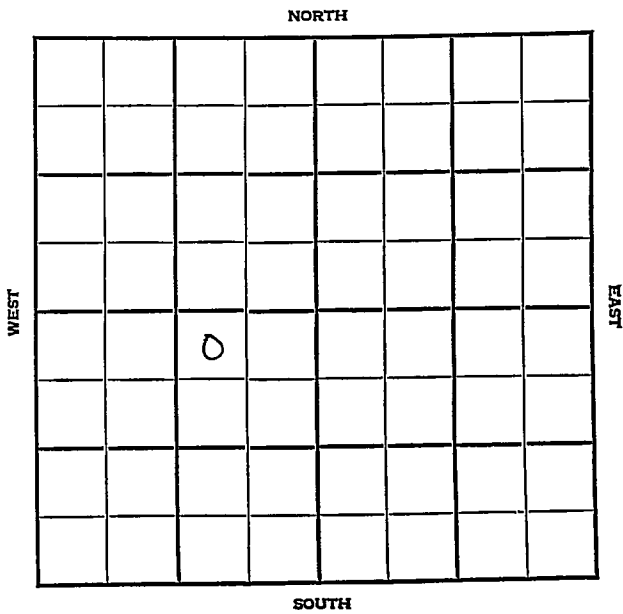



Sec. 28 Twp. 14 R. 13W

Well No. #14 Colliver Farm
Skelly Company

Hall-Gurney


330' Ft. from N. Line

_____ Ft. from S. Line

990' Ft. from E. Line

_____ Ft. from W. Line

NW NE SW

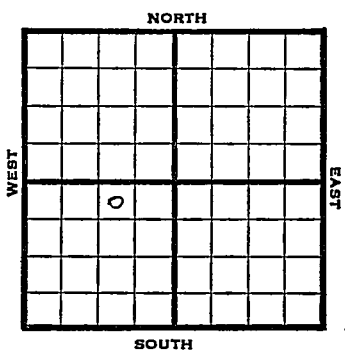

1948

Elev. 1735' REPORT

6/23

Location

6/29

"

7/8

"

7/14

"

7/21

"

7/28

Drlg 677'

8/4

8" @ 680'

Lansing 2864'

TD 2885'

5" @ 2884'

8/11

"

8/18

TD 2964' 6000 acid

8/25

Pump 188 oil SW in 16 hrs.

9/1

"

9/8

Lans. 2864'

5" @ 2884'

TD 2964'

6000 acid

Pump 172 oil Pot.

Gravity 40.90

COMPLETED

Map No. _____ Sec. 28 Twp. 14 R. 13W

Well No. 14 Colliver

Skelly _____ Company

FIRST REPORT _____ Contractor

NW NE SW

SECTION PLAT

330 Ft. from N. Line

_____ Ft. from S. Line

990 Ft. from E. Line

_____ Ft. from W. Line

	o		

Russell County

Location _____ X

Rig up _____

Drilling and Remarks: .

RECORD

Cased _____ in., _____ ft.

Sand _____

Gas _____

Oil _____

Total Depth _____

PRODUCTION

1st 24 hrs. Nat. _____

1st 24 hrs. after shot _____

Gas _____ Cu. Ft.

Dry Hole _____

Abandoned _____

Date

JUN 23 1948 19 S. J. LEWIS Scout

Russell County Kansas State

Map No. 72 Sec. 28 Twp. 14 R. 13W

Well No. 14 Colliver

Skelly Company

COMPLETE

Contractor

NW NE SW

E. 1235

SECTION PLAT

330 Ft. from N. Line

 Ft. from S. Line

990 Ft. from E. Line

 Ft. from W. Line

Hall-Gurney Pool

Remarks:

Leans 286.4
5" @ 2884
WD 2964
6000 acc'd
Prod 172 oil Prod
40 9/92

Date SEP 8 1948

Scout S. J. LEWIS