

KANSAS


Russell

FORM 51 5M 4-41 PETROL

Section 28 Township 14 Range 13W

Well No. 13-Colliver

Company Skelly Oil

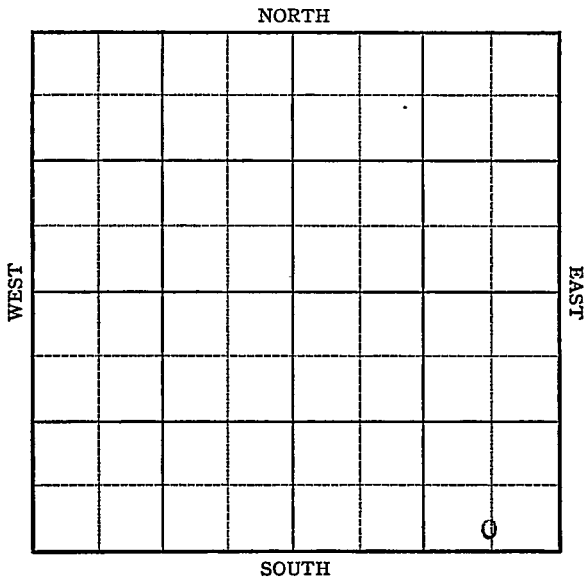

3

Sec. 28 Twp. 14 R. 13-W

Well No. #13 Colliver Farm

Skelly Oil Company


(Hall-Gurney)

_____ Ft. from N. Line

330 Ft. from S. Line

660 Ft. from E. Line

_____ Ft. from W. Line

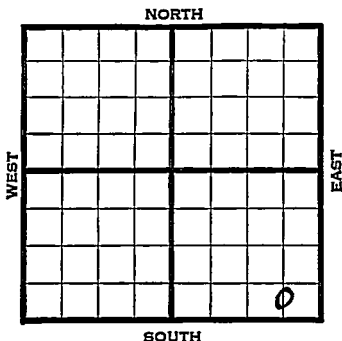

Elev. 1727

1941	REPORT
9/3	10" - 280' WOC.
9/11	Drlg. 2627'
9/18	Dodge 2803' Lans. 2853-88' T.D.
	6" - 2885' RUST.
9/24	Lans. 2853'
	6" - 2885'
	T.D. 2955'
	7000 acid.
	Potential 490 bbls., pump.
	38.3 Gravity
	COMPLETED

Map No. _____ Sec. 28 Twp. 14 R. 13^W

Well No. 13 Colliver

Skelly Oil Company

FIRST REPORT Contractor

C S L S E S E

_____ Ft. from N. Line

330 Ft. from S. Line

660 Ft. from E. Line

_____ Ft. from W. Line

SECTION PLAT

			6

HALL GURNEY POOL

Location _____

Rig up _____

Drilling and Remarks:

10" - 280
WOC

RECORD

Cased _____ in., _____ ft.

Sand _____

Gas _____

Oil _____

Total Depth _____

PRODUCTION

1st 24 hrs. Nat. _____

1st 24 hrs. after shot _____

Gas _____ Cu. Ft.

Dry Hole _____

Abandoned _____

Date

SEP 3 1941₁₉

S. J. LEWIS Scout

