

KANSAS

Form 51-5M-7-40-Palace

O.W.W.O.

Russell


KANSAS

Section 28 Township 14 Range 13-W

Well No. #9 Colliver

Company Skelly Oil

Hall-~~Pool~~ *Gurney Pool*

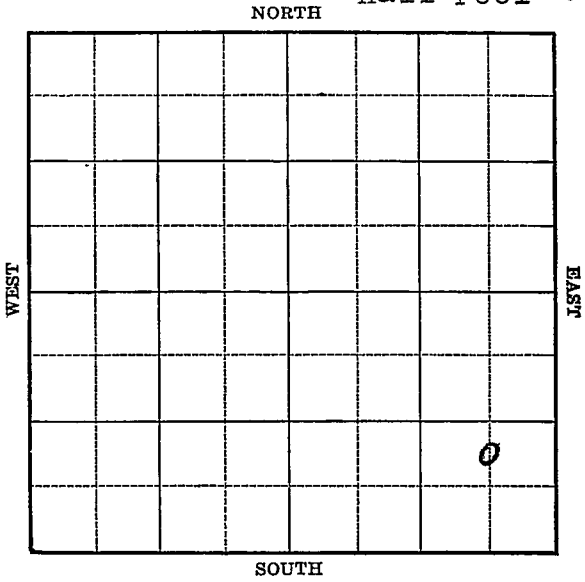

Sec. 28 Twp. 14 R. 13-W

Well No. #9 Colliver Farm

Skelly Oil Company

~~(Hall)~~ Hall-Gurney Pool


         Ft. from N. Line

990 Ft. from S. Line

660 Ft. from E. Line

         Ft. from W. Line

C N/2 SE SE  
Elev. 1726

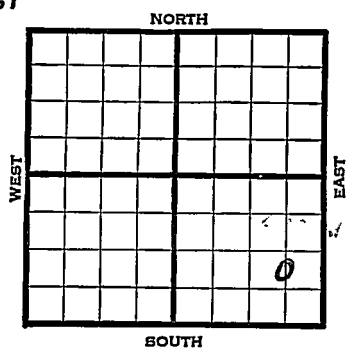

1940	REPORT
12/4	Cellar.
12/12	10" - 276' WOC.
12/19	1884' fsg. drill pipe.
12/26	Drlg. 1927'
1941	
1/2	Drlg. 2600'
1/9	Lans. 2853' 6" - 2882'
	T.D. 2954' 1500' oil.
1/15	Lans. 2853'
	6" - 2882'
	T.D. 2954'
	8000 acid.
	Depthograph potential 2717 oil &
	129 water. 38.4 Gravity
	<b>COMPLETED</b>
1955	<b>O.W.W.O.</b>
8/10	OTD 2954'. 6" @ 2882' DD 2983'
	2000 A P/27 BO, 92 BW 14 hrs.
	PB 2876; 36/2871-75; 1000 A; PB 2820
	54/2799-2805; 3250 A P/45 BO 18 BW
	16 hr. CO to 2980' P/50 BOPD 9% wtr
	H. 2780', Tr. 2797', Dg 2813', L. 2849

Map No. 72 Sec. 28 Twp. 14 R. 13WWell No. 9 ColliverSkelly Oil

Company

Contractor

**FIRST REPORT**

C N L SE SE

         Ft. from N. Line990 Ft. from S. Line660 Ft. from E. Line         Ft. from W. Line

HALI POOL

**SECTION PLAT**

			o

Location                                 Rig up                                 

Drilling and Remarks:

Cellar

**RECORD**Cased          in.,          ft.Sand                                 Gas                                 Oil                                 Total Depth                         **PRODUCTION**1st 24 hrs. Nat.                         1st 24 hrs. after shot                         Gas                                  Cu. Ft.Dry Hole                                 Abandoned                                 

Date

DEC 4 1940 19S. J. LEWIS Scout



O.W.W.O.

~~ONWO~~

FORM 513 REV. SUNRAY

County Russell Elev. 1726  
 Sec. 28 Twp. 14 Rgs. 13W  
 Company Skelly Oil  
 FarmName G. Colliver No. 9

TOPS	DEPTH	LOG	DATUM
Anb.			
TP.		2780	
H.		2792	
Tr.		2813	
Dg.		2849	
Bl.			
L.			
K.C.			
B.K.C.			
Ce.			
C.			
M.			
M.			
K.			
Mz.			
Me.			
V.			
S.			
S.			
A.			
R.			
PE.			
G.			
T.B.			

Loc. in Sec. C N<sup>1</sup>/<sub>2</sub> SE SE

Geol. \_\_\_\_\_  
Contr. \_\_\_\_\_

Pool Hall-Gurney

AUG 10 '55  
FIRST REPORT COMPLETE

Date Comm. 6" @ 2882 OTD 2954 DD 2983 2000 A  
 P/ 27 bo 92 bw 14 hr. PB 2876  
 36/ 2871-75 1000 A PB 2820 54/ 2799-  
 2805 3250 A P/ 45 bo 18 bw 16 hr.  
 GO to 2980 P/ 50 bopd 9% wtr.

*[Handwritten signature]*