


Russell KANSAS

Section 28 Township 14 Range 13-W

Well No. 2 Giese

Company Shields et al

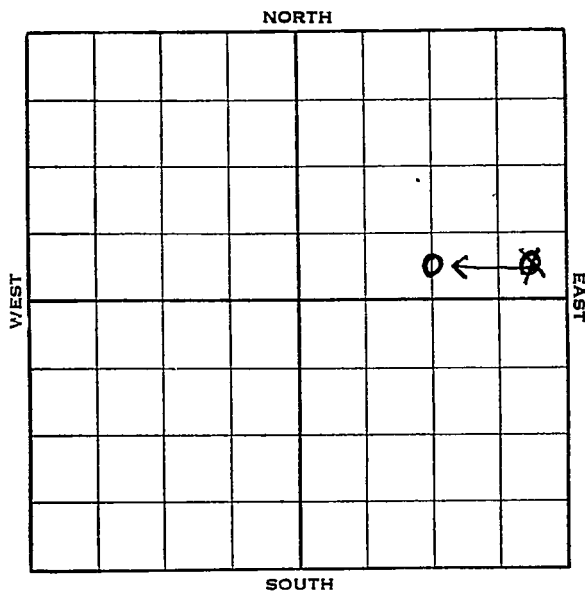

Sec. 28 Twp. 14 R. 13-W

Well No. #2 Giese Farm

Shields et al Company


_____ Ft. from N. Line

330 Ft. from S. Line

1320
~~990~~ Ft. from E. Line

_____ Ft. from W. Line

Elev. 1730

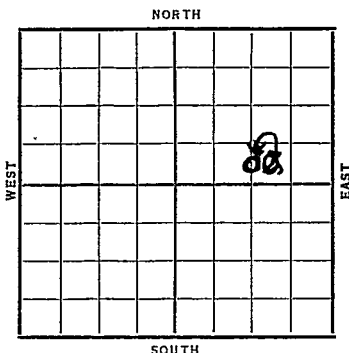

Date	REPORT
1938	
2/23	Cellar
3/4	"
3/11	"
3/18	B. C. R.
3/25	R. U.
4/1	"
4/8	"
4/15	"
4/22	Shut down.
4/29	" "
5/6	" "
5/12	" "
5/20	Spud.
5/27	20" @ 20'. 15" @ 151'.
	12" @ 361'. Drlg. 515'.
6/2	Drlg. 1190'.
6/10	S. O. & G 2196-2205'.
	8" @ 2352'. Drlg. 2370'.
6/17	K.C. 2846-82 T.D. 6" - 2882' WOC
	no shows.

OVER

1938

6/22

6" @ 2882'.

K. C. 2856'.

T.D. 2907'.

20,000 acid.

Pump 447 bbls. 4 hrs. &

456 bbls. 4 hrs.

Potential 2685 bbls.

COMPLETED

Map No. 72 Sec. 28 Twp. 14 R. 13WWell No. 2 GieseShields etal Company

Contractor

FIRST REPORT

SW SE NE

 Ft. from N. Line330 Ft. from S. Line990 Ft. from E. Line Ft. from W. Line

SECTION PLAT

			0

Location Rig up

Drilling and Remarks:

Cellar

RECORD

Cased in., ft.Sand Gas Oil Total Depth

PRODUCTION

1st 24 hrs. Nat. 1st 24 hrs. after shot Gas Cu. Ft.Dry Hole Abandoned

Date

FEB 23 1938 19 H. D. Hatfield Scout

Russell

KANSAS

Map No. 72 Sec. 28 Twp. 14 R. 13^w

Well No. 2 - Giese

Shields et al Company

Contractor

CSLNE

CORRECTION

SECTION PLAT

			50

_____ Ft. from N. Line

230 Ft. from S. Line

1320 Ft. from E. Line

_____ Ft. from W. Line

Location _____

Rig up _____

Drilling and Remarks:

*first reported
as sws ne
corrected to
the CSLNE*

RECORD

Cased _____ in., _____ ft.

Sand _____

Gas _____

Oil _____

Total Depth _____

PRODUCTION

1st 24 hrs. Nat. _____

1st 24 hrs. after shot _____

Gas _____ Cu. Ft.

Dry Hole _____

Abandoned _____

Date
MAR 16 1938

H. D. Hatfield

Russell KANSAS

Map No. 72 Sec. 28 Twp. 14 R. 13W

Well No. 2 Geise

Shields etal

Company

Contractor

COMPLETED

SECTION PLAT

C S L NE

_____ Ft. from N. Line

330 Ft. from S. Line

1320 Ft. from E. Line

_____ Ft. from W. Line

			o

Location _____

Rig up _____

Drilling and Remarks:

20,000 acid

*Pump 447/4 * 456/4*

POT 26.85

RECORD

Cased 6 in., 2882 ft.

Sand K.C. 2856

Gas _____

Oil _____

Total Depth 2907

PRODUCTION

1st 24 hrs. Nat. _____

1st 24 hrs. after shot _____

Gas _____ Cu. Ft.

Dry Hole _____

Abandoned _____

Date

JUN 22 1938 19

H. D. Hatfield

Scout