

KANSAS


FORM 51 5M 11-44 PETROL

Russell County

Section 28 - Township 14 Range 13W

Well No. #7 Giese

Company R. H. Shields

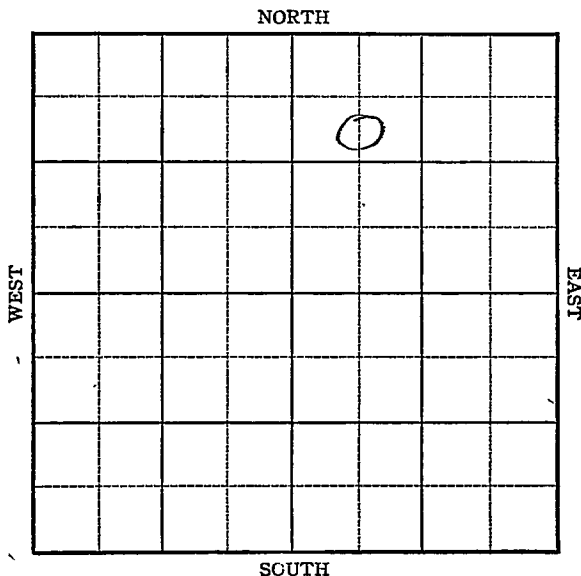

KANSAS

Russell County

Sec. 28 Twp. 14 R. 13WWell No. #7 Giese FarmR. H. Shields Company

Hall-Gurney


990 Ft. from N. Line

Ft. from S. Line

Ft. from E. Line

660 Ft. from W. Line

CSL NWNE

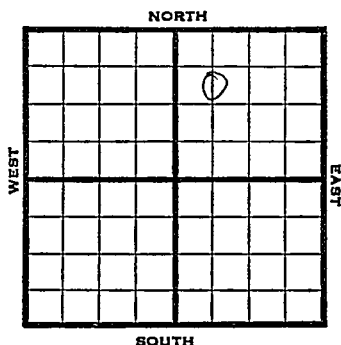

1946

Elev. 1748

REPORT

2/6	Spud		
2/14	15" - 70'	Anhy 688'	
	12" - 450'	Drlg. 790'	
2/21	10" - 697'	Drlg. 1705'	
2/28	8" - 2275'	Drlg. 2375'	
3/7	Lans. 2880'	7" - 2880'	
	Drlg. 2922'	S.O.	
3/14	H.F.W. 2923-30'	7" - 2937'	
	C.O. 2946'		
3/21	Drlg. 3148'		
3/28	Arb. 3153'	Basal 3175'	
	5" - 3184'	T.D. 3219'	
	RUST. S.W.D.		
4/4	"	"	"
4/10	"	"	"
4/16	"	"	"
4/23	"	"	"
5/1	Arb. 3153		
	Basal 3175		
	5" @ 3184		
	TD 3219' SWD		

ABANDONED

KANSAS Kansas Pool Name Hall-Gurney

Map No. 72 Sec. 28 Twp. 14 R. 13W

Well No. 7 Giese


R. H. Shields Company

FIRST REPORT

Contractor

C S L NW NE

SECTION PLAT

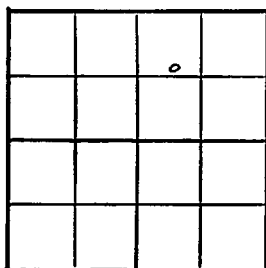

990 Ft. from N. Line

 Ft. from S. Line

 Ft. from E. Line

660 Ft. from W. Line

Russell County

Location

Rig up

Drilling and Remarks:

spud

RECORD

Cased in., ft.

Sand

Gas

Oil

Total Depth

PRODUCTION

1st 24 hrs. Nat.

1st 24 hrs. after shot

Gas Cu. Ft.

Dry Hole

Abandoned

Date


FEB 6 1946 19 S. J. LEWIS Scout

Kansas Pool Name Hall-Gurney**KANSAS**Map No. 72 Sec. 28 Twp. 14 R. 13WWell No. 7 GooseR. H. Shields

Company

ABANDONED

Contractor

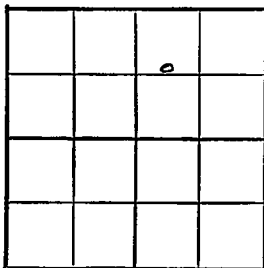C S L NW NEE11748
SECTION PLAT990 Ft. from N. Line Ft. from S. Line Ft. from E. Line660 Ft. from W. LineRussell CountyLocation Rig up

Drilling and Remarks:

Cor 3153
Base 3175
5' 03/84

BVD

RECORDCased in, ft.Sand Gas Oil Total Depth 2219**PRODUCTION**1st 24 hrs. Nat. 1st 24 hrs. after shot Gas Cu. Ft.Dry Hole Abandoned

Date

MAY 1 194619S. J. LEWISScout

check well No.
your 1st report ticket.
shows well #7
advised
Sam

Misc. Small Maps _____
Cards Joseph _____
Tracing 7 _____
France Map ✓ _____
Scarborough Map ✓ _____
Pierce Map _____
Geological Dept. _____
Pierce Plat Book _____