


Section 28 Township 14 Range 13W

Well No. #9 Giese

Company Shields Oil Prod.

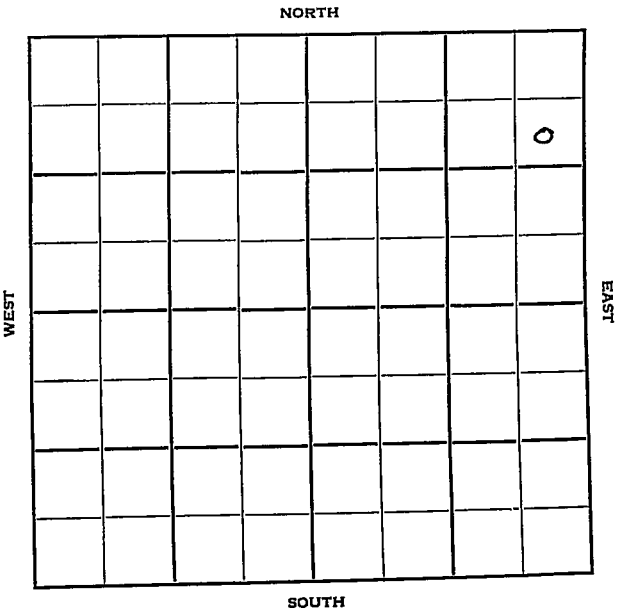

Sec. 28 Twp. 14 R. 13W

Well No. #9 Giese Farm

Shields Oil Prod. Company

Shields Contractor


990 Ft. from N. Line

Ft. from S. Line

330 Ft. from E. Line

Ft. from W. Line

NE 1/4 SE NE NE

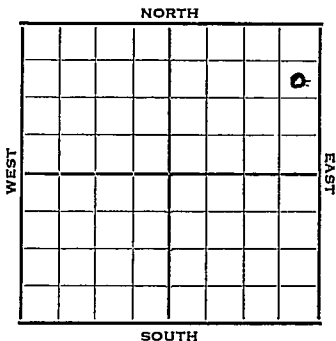

1952 Elev. 1752' REPORT

- 10/22 Location
- 10/29 15" @ 14 13" @ 390 Anhy 695'
10" @ 699
Drlg. 709'
- 11/5 Drlg. 1850'
- 11/12 Tarkio 2270
TD 2271' SO&G
7" @ 2270'
- 11/20 DD 2304' TD B/oil plus trace
- 11/27 TD 2304
PB 2292
St-frac
- 12/3 Spud 10-20-52
Oil Well
TD 2304'
15" @ 14
13" @ 390
Anhy 695'
10" @ 699
Tarkio 2270
TD 2271
7" @ 2270
DD 2304 B/oil tr. wtr.
PB 2292 st.-frac
Comp. 20 bopd

COMPLETED

County Russell State Kansas

Sec. 28 (Blk. Twp.) 14 (Sur. Rge.) 1 SW Map No.

Operator Shields Oil Prod.

Well No. 9 Farm Giese

Elev. _____ Location SE NE NE

									0

990 Ft. From N Line NE

330 Ft. From E Line Quarter

1st. Report OCT 22 1952

Completion _____

Remarks _____

Shields - Contr.

Spudding Date _____

Drlg. Data _____

Location
