

# KANSAS

Form 51-5M-7-40-Palace


Russell

Section 28 Township 14 Range 13-W

Well No. #8 Colliver

Company Skelly Oil

NORTH Hall Pool

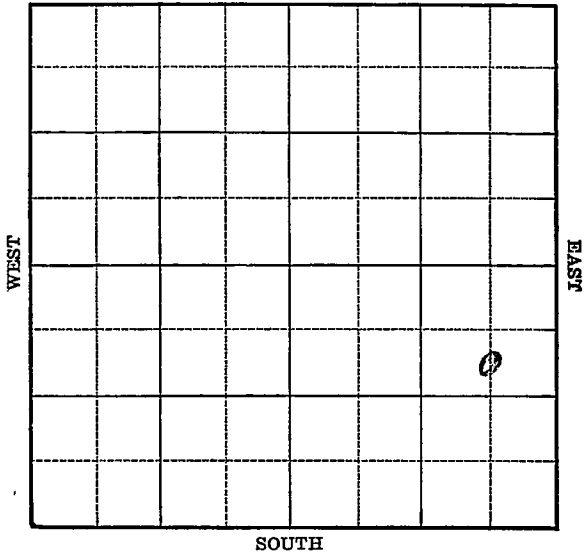

Sec. 28 Twp. 14 R. 13 -W

Well No. #8 Colliiver Farm

Skelly Oil Company

(Hall)


990 Ft. from N. Line

\_\_\_\_\_ Ft. from S. Line

660 Ft. from E. Line

\_\_\_\_\_ Ft. from W. Line

Elev. 1716

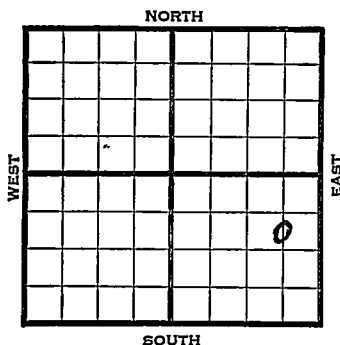

| 1940. | REPORT                      |
|-------|-----------------------------|
| 11/13 | Location                    |
| 11/21 | R.U.R.                      |
| 11/27 | 10" - 284'                  |
|       | Drig. 630'                  |
| 12/5  | Drig. 2754'                 |
| 12/12 | Dodge 2794' Lans. 2843'     |
|       | 6" - 2872' T.D. 2890' 1200' |
|       | oil 10 hours.               |
| 12/18 | Lans. 2843'                 |
|       | 6" - 2872'                  |
|       | T.D. 2890'                  |
|       | 6500 acid.                  |
|       | Potential 1666 bbls., pump. |
|       | 38.4 Gravity                |
|       | <b>COMPLETED</b>            |

Map No. 72 Sec. 28 Twp. 14 R. 13WWell No. 8 Colliver  
Skelly Oil

Company \_\_\_\_\_

Contractor \_\_\_\_\_

## FIRST REPORT

C S L N E S E

990 Ft. from N. Line

\_\_\_\_\_ Ft. from S. Line

660 Ft. from E. Line

\_\_\_\_\_ Ft. from W. Line

HALT POOL

## SECTION PLAT

|  |  |  |   |
|--|--|--|---|
|  |  |  |   |
|  |  |  |   |
|  |  |  |   |
|  |  |  | o |
|  |  |  |   |

Location X

Rig up \_\_\_\_\_

Drilling and Remarks:

## RECORD

Cased \_\_\_\_\_ in., \_\_\_\_\_ ft.

Sand \_\_\_\_\_

Gas \_\_\_\_\_

Oil \_\_\_\_\_

Total Depth \_\_\_\_\_

## PRODUCTION

1st 24 hrs. Nat. \_\_\_\_\_

1st 24 hrs. after shot \_\_\_\_\_

Gas \_\_\_\_\_ Cu. Ft.

Dry Hole \_\_\_\_\_

Abandoned \_\_\_\_\_

Date

NOV 13 1940 19

S. J. LEWIS Scout

Map No. 72 Sec. 28 Twp. 14 R. 13WWell No. 8 ColliverSkelly Oil

Company

Contractor

**COMPLETED**

C S L N E S E

990 Ft. from N. Line

\_\_\_\_\_ Ft. from S. Line

660 Ft. from E. Line

\_\_\_\_\_ Ft. from W. Line

HALL POOL

**SECTION PLAT**

|  |  |  |   |
|--|--|--|---|
|  |  |  |   |
|  |  |  |   |
|  |  |  |   |
|  |  |  | o |

Location \_\_\_\_\_

Rig up \_\_\_\_\_

Drilling and Remarks:

*Trans. 2843**6" @ 2872.**6500 Acid**Pump. 1666 P.D.**38.4 Gr***RECORD**

Cased \_\_\_\_\_ in., \_\_\_\_\_ ft.

Sand \_\_\_\_\_

Gas \_\_\_\_\_

Oil \_\_\_\_\_

Total Depth 2890**PRODUCTION**

1st 24 hrs. Nat. \_\_\_\_\_

1st 24 hrs. after shot \_\_\_\_\_

Gas \_\_\_\_\_ Cu. Ft.

Dry Hole \_\_\_\_\_

Abandoned \_\_\_\_\_

Date

DEC 18 1940 19S. J. LEWIS

Scout