


Section 28 Township 14 Range 13-W

Well No. #7 Colliver

Company Skelly Oil

NORTH **Hall Pool**

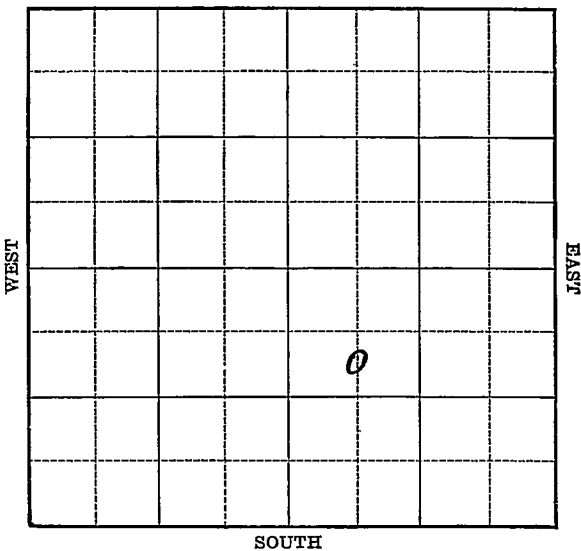

Russell

KANSAS

Map No. 72 Sec. 28 Twp. 14 R. 13W

Well No. 7 Calliver

Skelly Oil Company

FIRST REPORT Contractor

C S L NW SE

SECTION PLAT

991 Ft. from N. Line

		o	

_____ Ft. from S. Line

_____ Ft. from E. Line

660 Ft. from W. Line

HALL POOL

Location _____

RECORD

Rig up _____

Cased _____ in., _____ ft.

Drilling and Remarks: ¹

Sand _____

Cellar & Pits ✓

Gas _____

Oil _____

Total Depth _____

PRODUCTION

1st 24 hrs. Nat. _____

1st 24 hrs. after shot _____

Gas _____ Cu. Ft.

Dry Hole _____

Abandoned _____

Date

MAY 19 1940

S. J. LEWIS

Scout

Map No. 72 Sec. 28 Twp. 14 R. 13W

Well No. 7 Colliver

Skelly Company

Contractor

COMPLETED

C S L NW SE

SECTION PLAT

991 Ft. from N. Line

_____ Ft. from S. Line

_____ Ft. from E. Line

660 Ft. from W. Line

		o	

HALL POOL

Location _____

Rig up _____

Drilling and Remarks:

Lave 2867

7" C 2893

6000 acc/c

Pump 1324 P.T.

RECORD

Cased _____ in., _____ ft.

Sand _____

Gas _____

Oil _____

Total Depth 2916.

PRODUCTION

1st 24 hrs. Nat. _____

1st 24 hrs. after shot _____

Gas _____ Cu. Ft.

Dry Hole _____

Abandoned _____

Date

JUN 5 1940 19

S. J. LEWIS Scout